

MAR 09 1994

Chippewa County Remonumentation Corner

LAND CORNER RECORDATION CERTIFICATE
Filing Requirement of Act 74, Mich. P.A. 1970

RECEIVED FOR RECORD
CHIPPEWA COUNTY
STATE OF MICHIGAN

93 DEC 29 AM 10:26

For corners in CHIPPENAW


Chippewa (County)	Located In:	Corner Code #
1. Public Land Survey	T <u>46N</u> R <u>1E</u>	<u>I-4</u>
	T _____ R _____	_____
	T _____ R _____	_____
	T _____ R _____	_____
2. Property Controlling in Section	S _____ T _____ R _____	_____
	S _____ T _____ R _____	_____
3. Miscellaneous Property in Sec.	S _____ T _____ R _____	_____
	S _____ T _____ R _____	_____
4. Lot No. _____, Recorded Plat _____		
5. Private Claims _____		

J. Roger Mahalle
REGISTER OF DEEDS

Register of Deeds Stamp & File Number

I, Larry R. Rogers, in a field survey on November 16, 19 93, do hereby certify that under requirements of P.A. 74, Michigan P.A. of 1970, the corner points mentioned in lines 1 and 2 above were in conformance with regulations and rules therefore as required in the current manual of survey instructions of the United States Department of the Interior, Bureau of Land Management or by a decree of a Court of Law and/or that the corner points mentioned in lines 3, 4 and 5 above were in conformance with the rules of the Michigan Board of Land Surveyors or by a Decree of a Court of Law; established, re-established, monumented, re-monumented, recovered, found as expressed below:


NOTE: Not more than 4 corners, all in the same town and range, may be recorded on this certificate.

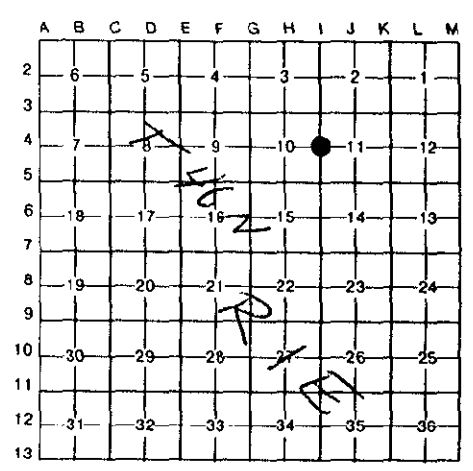

A. Description of original monument and accessories and/or subsequent restoration:
(I-4) 1/4 Corner Common to Sections 10 and 11, T46N-R1E

This corner position was restored in 1984 by W. L. Karr, and recorded in Liber 6, Page 108 of the Chippewa County Corner Records as a 1/2" iron pin in the centerline of Riverside Drive with the following witnesses:

Fence Post	N51°E	64.60'
Fence Post	S58°W	61.27'
Fence Post	S86°E	57.65'
Centerline East-West 48" Culvert	North	13.00'

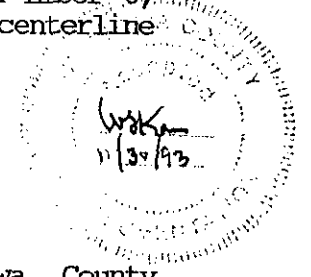

B. Description of corner evidence found and/or method applied in restoring or reestablishing corner:

(I-4) This corner is being perpetuated as part of the Chippewa County Remonumentation Program.

This corner was removed by the Chippewa County Road Commission during reconstruction of Riverside Drive and replaced by an empty monument box at the approximate corner position. The three previous fence post witnesses are all leaning and distances from them do not intersect properly. The 48" culvert has been replaced. Corner position was re-established midway and on the line between the Northeast and Southeast corners of Section 10, and falls just South of the monument box.

C. Description of monument for corner and accessories established to perpetuate locating the position of the corner:

(I-4) Corner is a 3/4" x 24" iron pin with plastic remonumentation cap in the centerline of Riverside Drive.

Witnesses: Center of monument box	North	0.46'
Corner fence post (leaning)	N57°E	65.03'
"V" cut in West end of 48" C.M.P.	N56°W	37.08'
"V" cut in East end of 48" C.M.P.	N72°E	35.77'
Corner fence post (leaning)	S86°E	57.94'
Fence post (leaning)	S58°W	60.97'



Signed by [Signature] Date 30 Nov 1993
Surveyor's Michigan License No. 29251

NOTE: Bearings are compass bearings corrected for declination.
Distances are to a nail in side of witness objects unless noted.