

LAND CORNER RECORDATION CERTIFICATE  
Filing Requirement of Act 74, Mich. P.A. 1970

For corners in  
Chippewa  
(County)

Located in:	T <u>46N</u> R <u>1E</u>	Corner Code # <u>I-7</u>
	T _____ R _____	_____
	T _____ R _____	_____
	T _____ R _____	_____
	T _____ R _____	_____
2. Property Controlling in Section	S _____ T _____ R _____	_____
	S _____ T _____ R _____	_____
3. Miscellaneous Property in Sec.	S _____ T _____ R _____	_____
	S _____ T _____ R _____	_____

RECEIVED FOR RECORD  
CHIPPEWA COUNTY  
STATE OF MICHIGAN


94 JUL 22 AM 11:16

*J. Roger Melville*  
REGISTER OF DEEDS

Register of Deeds Stamp & File Number

4. Lot No. \_\_\_\_\_, Recorded Plat \_\_\_\_\_  
5. Private Claims \_\_\_\_\_

I, Larry R. Rogers, in a field survey on NOVEMBER 23, 19 93, do hereby certify that under requirements of P.A. 74, Michigan P.A. of 1970, the corner points mentioned in lines 1 and 2 above were in conformance with regulations and rules therefore as required in the current manual of survey instructions of the United States Department of the Interior, Bureau of Land Management or by a decree of a Court of Law and/or that the corner points mentioned in lines 3, 4 and 5 above were in conformance with the rules of the Michigan Board of Land Surveyors or by a Decree of a Court of Law; established, re-established, monumented, re-monumented, recovered, found as expressed below:

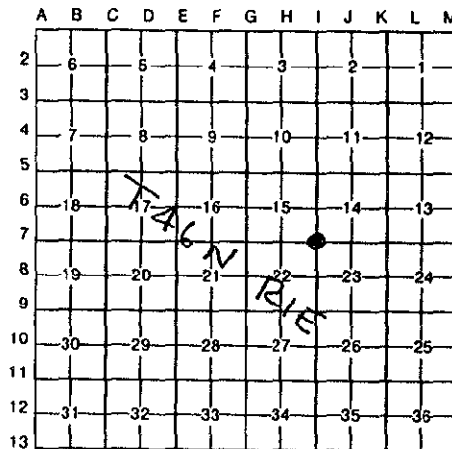

NOTE: Not more than 4 corners, all in the same town and range, may be recorded on this certificate.

A. Description of original monument and accessories and/or subsequent restoration:  
(I-7) Southeast Corner of Section 15 (T46N-R1E)  
Original survey notes: Set post Corner Sections 14, 15, 22 and 23  
Willow 6 N43W 18 Tamarack 10 S13E 9  
County Surveyor, Brown, set a gas pipe in 1908.

1987: L.R. Rogers set 1/2" x 18" iron with cap #29251 (L.7, P.014).  
Power Pole (DR1/76A/30) N54°E 84.23'  
Power Pole (DR1/76A2/1) S52°E 84.08'  
Northeast Corner of Store S60°W 95.09'  
Corner Fence Post N43°W 72.58'

B. Description of corner evidence found and/or method applied in restoring or reestablishing corner:  
(I-7) Found corner and accessories as recorded in Liber 7, Page 014 of the Chippewa County Records. Accepted corner position as found.

SURVEY &  
REMONUMENTATION

JUL 26 1994

COMMISSION



C. Description of monument for corner and accessories established to perpetuate locating the position of the corner:  
(I-7) Corner is a 1 1/2" iron pipe in an intersection.

Witnesses:

Power Pole (DR1/76A/30)	N54°E	84.23'
Power Pole (DR1/76A2/1)	S52°E	84.08'
Northeast Corner of Store	S60°W	95.09'
Corner Fence Post	N43°W	72.58'

Signed by [Signature]

Date 20 July 1994

Surveyor's Michigan License No. 29251

398-00

NOTE: Bearings are compass bearings corrected for declination. Distances are to a nail in side of witness objects unless noted.