

SURVEY & RECONSTRUCTION

MAR 09 1894

COMMISSION

Chippewa County Remonumentation Corner

LAND CORNER RECORDATION CERTIFICATE Filing Requirement of Act 74, Mich. P.A. 1970

RECEIVED FOR RECORD
CHIPPEWA COUNTY
STATE OF MICHIGAN

93 DEC 29 AM 10:26


J. Roper Malott
REGISTER OF DEEDS

For corners in

<u>Chippewa</u> <small>(County)</small>	Located In:	Corner Code #
1. Public Land Survey	T <u>46N</u> R <u>1E</u>	<u>I-10</u>
	T _____ R _____	_____
	T _____ R _____	_____
	T _____ R _____	_____
2. Property Controlling in Section	S _____ T _____ R _____	_____
	S _____ T _____ R _____	_____
3. Miscellaneous Property in Sec.	S _____ T _____ R _____	_____

Register of Deeds Stamp & File Number

- 4. Lot No. _____, Recorded Plat _____
- 5. Private Claims _____

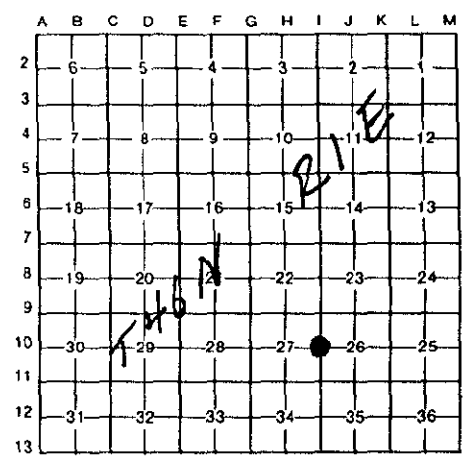

I, Larry R. Rogers, in a field survey on November 11, 1993, do hereby certify that under requirements of P.A. 74, Michigan P.A. of 1970, the corner points mentioned in lines 1 and 2 above were in conformance with regulations and rules therefore as required in the current manual of survey instructions of the United States Department of the Interior, Bureau of Land Management or by a decree of a Court of Law and/or that the corner points mentioned in lines 3, 4 and 5 above were in conformance with the rules of the Michigan Board of Land Surveyors or by a Decree of a Court of Law; established, re-established, monumented, re-monumented, recovered, found as expressed below:

NOTE: Not more than 4 corners, all in the same town and range, may be recorded on this certificate.

A. Description of original monument and accessories and/or subsequent restoration:
(I-10) 1/4 Corner Common to Sections 26 and 27, T46N-R1E


Original Survey Notes : Sept. 14, 1845 James H. Mullett
 Set Quarter Section Post
 10" Birch N64°W 14 links
 8" Maple S89°E 12 links

B. Description of corner evidence found and/or method applied in restoring or reestablishing corner:
(I-10) This corner is being perpetuated as part of the Chippewa County Remonumentation Program.

Found no evidence of original corner position. Corner position was reestablished by R. Bischer, P.S. 22428, on line between the Northeast and Southeast corners of Section 27 and on the extension of a fence line to the West. Accepted corner position as found.

C. Description of monument for corner and accessories established to perpetuate locating the position of the corner:
(I-10) Corner is a 1/2" iron pin 2.5' West of centerline of Riverside Drive.

Witnesses: End Guard Rail Post	N08°W	102.60'
North Gate Post	N65°W	51.25'
Corner Fence Post	N88°W	46.10'
6" Elm	N85°E	90.42'
Corner Fence Post	S78°E	53.75'
1/2" Iron Pin	East	50.00'

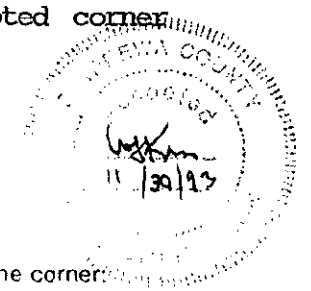

Signed by *Larry R. Rogers* Date 30 Nov 1993
 Surveyor's Michigan License No. 29251

NOTE: Bearings are compass bearings corrected for declination.
 Distances are to a nail in side of witness objects unless noted.