

MAR 09 1994

Chippewa County Remonumentation Corner

RECEIVED FOR RECORD  
CHIPPEWA COUNTY  
STATE OF MICHIGAN

LAND CORNER RECORDATION CERTIFICATE

Filing Requirement of Act 74, Mich. P.A. 1970

93 DEC 29 AM 10: 27

COMMISSION

For corners in

Chippewa

(County)

Located In:

Corner Code #

1. Public Land Survey	T <u>46N</u> R <u>1E</u>	<u>I-12</u>
	T _____ R _____	_____
	T _____ R _____	_____
	T _____ R _____	_____
2. Property Controlling in Section	S _____ T _____ R _____	_____
	S _____ T _____ R _____	_____
3. Miscellaneous Property in Sec.	S _____ T _____ R _____	_____
	S _____ T _____ R _____	_____

*J. Roger Marble*  
REGISTER OF DEEDS

Register of Deeds Stamp & File Number

- 4. Lot No. \_\_\_\_\_, Recorded Plat \_\_\_\_\_
- 5. Private Claims \_\_\_\_\_

I, Larry R. Rogers, in a field survey on November 11, 1993

do hereby certify that under requirements of P.A. 74, Michigan P.A. of 1970, the corner points mentioned in lines 1 and 2 above were in conformance with regulations and rules therefore as required in the current manual of survey instructions of the United States Department of the Interior, Bureau of Land Management or by a decree of a Court of Law and/or that the corner points mentioned in lines 3, 4 and 5 above were in conformance with the rules of the Michigan Board of Land Surveyors or by a Decree of a Court of Law; established, re-established, monumented, re-monumented, recovered, found as expressed below:

NOTE: Not more than 4 corners, all in the same town and range, may be recorded on this certificate.

A. Description of original monument and accessories and/or subsequent restoration:

(I-12) 1/4 Corner Common to Sections 34 and 35, T46N-R1E

This corner was previously recorded in 1983 by W.L. Karr in Liber 6, Page 120 of the Chippewa County Corner Records as a 1/2" iron pin set on line between the Northeast and Southeast corners of Section 34 and on the extension of a fence line to the West.

Witnesses: 18" Oak	N69°E	38.12'
12" Maple	S63°E	52.72'
Pole	S45°W	69.39'
8" Spruce	N87°W	51.57'

B. Description of corner evidence found and/or method applied in restoring or reestablishing corner:



(I-12) This corner is being perpetuated as part of the Chippewa County Remonumentation Program.

Corner was removed by the Chippewa County Road Commission during reconstruction of Riverside Drive and replaced with a monument box. Found 1/2" iron pin in monument box, 5' East of centerline of Riverside Drive. Corner position checks with two remaining witnesses from 1983 record (Spruce & Oak). Accepted corner position as found and established two new witnesses.

C. Description of monument for corner and accessories established to perpetuate locating the position of the corner:

(I-12) Corner is a 1/2" iron pin with P.S. cap #27450 in monument box, 5' East of centerline of Riverside Drive.

Witnesses: 18" Oak	N69°E	38.03'
8" Spruce	N87°W	51.54'
20" Triple Willow	S57°W	52.23'
Utility Pole (8B)	S47°E	42.94'

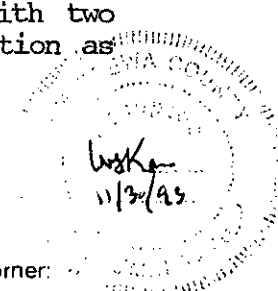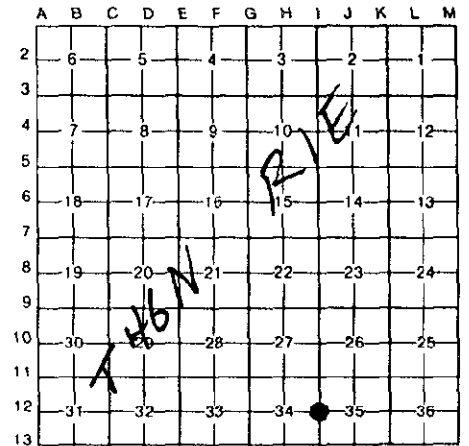

Signed by *[Signature]*

Date 30 Nov 1993

Surveyor's Michigan License No. 29251

NOTE: Bearings are compass bearings corrected for declination. Distances are to a nail in side of witness objects unless noted.