

1993

COMMISSION

Chippewa County Remonumentation Corner

LAND CORNER RECORDATION CERTIFICATE
Filing Requirement of Act 74, Mich. P.A. 1970

RECEIVED FOR RECORD
CHIPPEWA COUNTY
STATE OF MICHIGAN

93 NOV 31 AM 9:54

J. Roger Malott
REGISTER OF DEEDS


For corners in

Chippewa (County)	Located In:	Corner Code #
1. Public Land Survey	T 47N R 1E T 46N R 1E T _____ R _____ T _____ R _____	J-13 Same <u>J-1</u> Corner
2. Property Controlling in Section	S _____ T _____ R _____ S _____ T _____ R _____	_____
3. Miscellaneous Property in Sec.	S _____ T _____ R _____ S _____ T _____ R _____	_____

Register of Deeds Stamp & File Number

4. Lot No. _____ Recorded Plat _____
5. Private Claims _____

I, William L. Karr, in a field survey on May 20, 19 93, do hereby certify that under requirements of P.A. 74, Michigan P.A. of 1970, the corner points mentioned in lines 1 and 2 above were in conformance with regulations and rules therefore as required in the current manual of survey instructions of the United States Department of the Interior, Bureau of Land Management or by a decree of a Court of Law and/or that the corner points mentioned in lines 3, 4 and 5 above were in conformance with the rules of the Michigan Board of Land Surveyors or by a Decree of a Court of Law; established, re-established, monumented, re-monumented, recovered, found as expressed below:

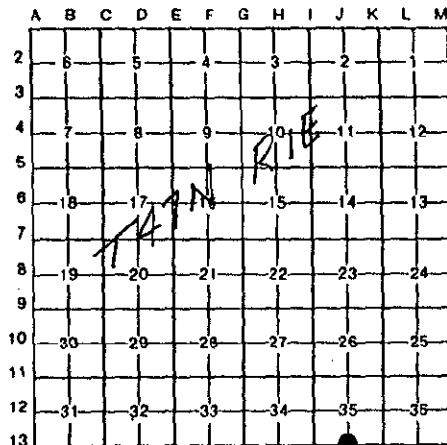

NOTE: Not more than 4 corners, all in the same town and range, may be recorded on this certificate.

A. Description of original monument and accessories and/or subsequent restoration:

(J-13) 1/4 Corner Sections 35 & 2

1978 T.M. Kelley, L.S. 24599, Granger Engineering Survey (SSU-1256-00). Shows the North 1/4 corner of Section 2 as being in place.

1988 L.R. Rogers, L.S. 29251, Northwoods, Inc. (Job Number 881-00).


Found a 1/2" iron L.S. 24599 with nails and L.S. tags 24599 in sides of witness objects.

Telephone Pole (cut off)	S44°E	45.76'
Power Pole	S55°W	50.85'
Power Pole	N46°W	46.57'

B. Description of corner evidence found and/or method applied in restoring or reestablishing corner:

(J-13) This corner is being perpetuated as part of the Chippewa County Remonumentation Program.

Found a 1/2" iron (no cap) 12" below newly paved and filled Nicolet Road. Corner matched ties called for in Northwoods survey. Placed a monument box over corner and raised up with a 3/4" iron and stamped aluminum cap. Added an additional tie. Accepted corner position as found.

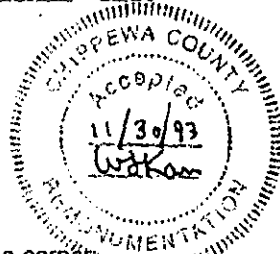

C. Description of monument for corner and accessories established to perpetuate locating the position of the corner:

(J-13) Corner is a 3/4" iron with stamped 2 1/2" diameter aluminum cap (Chippewa County Monumentation) P.S. 27450 in monument box 3' West of centerline of Nicolet Road on centerline of 6 Mile Road East and West.

Witnesses: Pole (cut off)	S44°E	45.76'
Power Pole (DR1/76A/90)	S55°W	50.85'
Power Pole (DR1/76A9/1)	N46°W	46.43'
"V" cut in North end culvert	N53°W	26.62'



Signed by William L. Karr Date 11/17/93
Surveyor's Michigan License No. 27450

NOTE: Bearings are compass bearings corrected for declination.
Distances are to a nail in side of witness objects unless noted.