

SURVEY & REMONUMENTATION

APR 27 1995

COMMISSION

CHIPPEWA COUNTY REMONUMENTATION CORNER

LAND CORNER RECORDATION CERTIFICATE

Filing Requirement of Act 74, Mich. P.A. 1970

For corners in

Chippewa

(County)

Located In:

Corner Code J-5

- | | | |
|---------------------------------------|--------------------------|------------|
| 1. Public Land Survey | T <u>46N</u> R <u>1E</u> | <u>J-5</u> |
| | T _____ R _____ | _____ |
| | T _____ R _____ | _____ |
| | T _____ R _____ | _____ |
| 2. Property Controlling in Section | S _____ T _____ R _____ | _____ |
| | S _____ T _____ R _____ | _____ |
| 3. Miscellaneous Property in Sec. | S _____ T _____ R _____ | _____ |
| | S _____ T _____ R _____ | _____ |
| 4. Lot No. _____, Recorded Plat _____ | | |
| 5. Private Claims _____ | | |

\$ 7.00 LAND CORNER
 \$ 2.00 MSSR
 5 DEC 94 12:10 P.M. RECEIPT# 1517
 RECEIVED FOR RECORD
 CHIPPEWA COUNTY - STATE OF MICHIGAN
 Register of Deeds

I, William L. Karr, in a field survey on October 19, 1994

do hereby certify that under requirements of P.A. 74, Michigan P.A. of 1970, the corner points mentioned in lines 1 and 2 above were in conformance with regulations and rules therefore as required in the current manual of survey instructions of the United States Department of the Interior, Bureau of Land Management or by a decree of a Court of Law and/or that the corner points mentioned in lines 3, 4 and 5 above were in conformance with the rules of the Michigan Board of Land Surveyors or by a Decree of a Court of Law; established, re-established, monumented, re-monumented, recovered, found as expressed below:

NOTE: Not more than 4 corners, all in the same town and range, may be recorded on this certificate.

A. Description of original monument and accessories and/or subsequent restoration:

(J-5) 1/4 Corner for Sections 11 & 14, T.46 N., R.1 E.

1845: J. Mullett set 1/4 post Fir 8 S01E 9
 Birch 8 N07E 9

1984 W.L. Karr re-established corner position by single pro-portionate measurement and set a 1/2"x18" iron. Corner is recorded in L.6, P.109.

Witnesses: 1/2"iron N84W 85.35' (should have been 81.35')
 P. Pole N86W 129.64'
 P. Pole S78W 38.06'
 3" W.Pine N08W 69.82'

B. Description of corner evidence found and/or method applied in restoring or reestablishing corner:



(J-5) This corner is being perpetuated as part of the Chippewa County Remonumentation program.

Found no evidence of original corner. Found 1/2" iron w/cap No. 27450 and several witnesses as recorded. Apparently a scrivener's error was made on the tie to the 1/2" iron. Recorded as 85.35', it should have read 81.35'. This was verified by reviewing the field notes for the corner placement. Accepted corner position as found.

C. Description of monument for corner and accessories established to perpetuate locating the position of the corner:

(J-5) Corner is a 1/2" iron with cap No. 27450, 0.5' below ground in a hay field. Corner is 81' East of the centerline of Nicolet Road.

Witnesses: 7" W. Pine N11°W 70.06'
 5" R. Pine N45°E 94.38'
 1/2" iron w/cap No.27450 N88°W 81.10'
 P. Pole West 129.40'

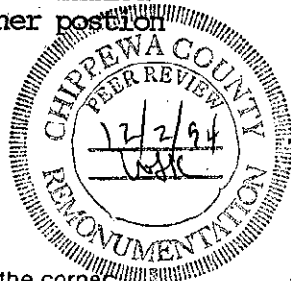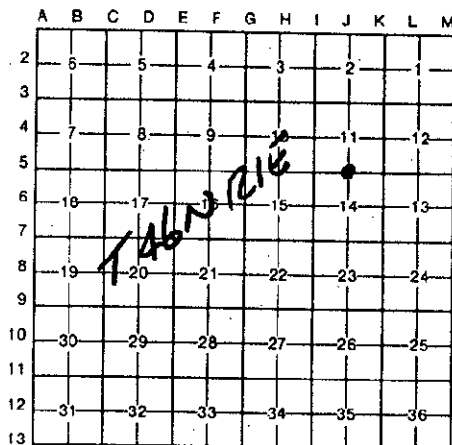

Signed by William L. Karr
 Surveyor's Michigan License No. 27450

Date 12/2/94

723-12

NOTE: Bearings are compass bearings corrected for declination.
 Distances are to a nail in side of witness objects unless noted.