

MAY 28 1997

COMMISSION

**LAND CORNER RECORDATION CERTIFICATE**  
**Filing Requirement of Act 74, Mich. P.A. 1970** LAND CORNER  
 Chippewa County Remonumentation Corner

For corners in

Chippewa County	Located in:	Corner Code #
1. Public Land Survey	T46N R1E	J-9
	T R	
	T R	
	T R	
2. Property Controlling in Section	S T R	
	S T R	
3. Miscellaneous Property in Sec.	S T R	
	S T R	
4. Lot No. , Recorded Plat		
5. Private Claims		


\$2.00 MSSR  
 2/28/1997 3:03:02 PM Receipt #217  
 RECEIVED FOR RECORD  
 CHIPPEWA COUNTY - STATE OF MICHIGAN  
 SHARON H. KENNEDY, REGISTER OF DEED

BOOK 9 PAGE 363

Register of Deeds Stamp & File Number

I, William L. Karr, in a field survey on October 30, 1996, do hereby state that under requirements of P.A. 74, Michigan P.A. of 1970, the corner points mentioned in lines 1 and 2 above were in conformance with regulations and rules therefore as required in the current manual of survey instructions of the United States Department of the Interior, Bureau of Land Management or by a decree of a Court of Law and /or that the corner points mentioned in lines 3, 4 and 5 above were in conformance with the rules of the Michigan Board of Land Surveyors or by a Decree of a Court of Law; established, re-established, monumented, recovered, found as expressed below:

NOTE: Not more than 2 corners, all in the same town and range, may be recorded on this certificate.

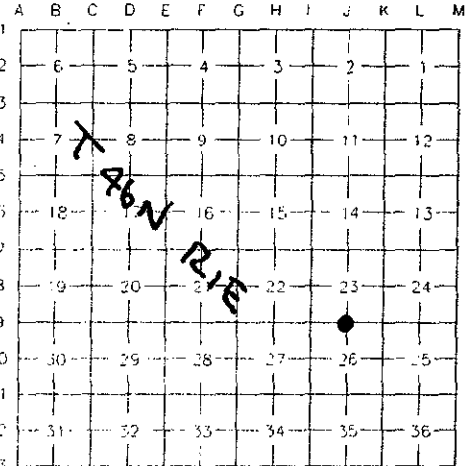

A. Description of original monument and accessories and/or subsequent restoration:

(J-9) 1/4 Corner Common to Sections 23 & 26, T. 46 N., R. 1 E.

- 1845 J.H. Mullett used a 6" tamarack for the 1/4 section post.
- 1902 F.H. Brown in records in County Surveyors Office for a survey in section 23 shows the mile as 5254' and evenly divided.
- 1907 F.H. Brown in records in County Surveyors Office for a survey in section 26 shows the mile the same as in 1902.
- 1993 R. Bischer, PS 22428, in a survey in section 26 shows the South and Center 1/4 corners of the section. Survey recorded in Liber 651, Page 124, Chippewa County Records.
- 1995 W.L. Karr, PS 27450, Northwoods Land Surveying Job 163-347. Reestablished the North 1/4 corner section 26 at intersection of North-South 1/4 line from Bischer survey and East-West section line.
- 1995 L.R. Rogers, PS 29251, Northwoods Land Surveying Job 3008-00, shows 1/4 corner position based on previous Bischer survey.

B. Description of corner evidence found and/or method applied in restoring or reestablishing corner:

(J-9) 1/4 Corner Common to Sections 23 & 26, T. 46 N., R. 1 E.

This corner is being perpetuated as part of the Chippewa County Remonumentation Program.

Found spike in centerline East-West gravel road at position shown in 1995 surveys. Spike falls on the range of an old fence line to the North and 6.6' East of an even split.

Accepted spike for corner position and replaced with 3/4" iron.

C. Description of monument for corner and accessories established to perpetuate locating the position of the corner:

(J-9) 1/4 Corner Common to Sections 23 & 26, T. 46 N., R. 1 E.

Corner is a 3/4" re-bar with plastic Chippewa County Remonumentation Cap. Corner falls in centerline of East-West gravel road and on the range of a fence to the North.

Witnesses:	Corner Fence Post	N 03° E	20.05'
	12" Aspen	N 46° E	68.60'
	5" Spruce	S 02° E	39.57'
	6" Spruce	S 55° W	43.67'

Bearings are compass bearings, corrected for declination, all distances are to a nail and tag in the side of the witness monument, otherwise noted.

Signed by William L. Karr

Date 12-30-96

Surveyor's Michigan License No. 27450

