

MAY 28 1997

LAND CORNER RECORDATION CERTIFICATE
Filing Requirement of Act 74, Mich. P.A. 1970
Chippewa County Remonumentation Corner


For corners in COMMISSION

Chippewa County	Located in:	Corner Code #
1. Public Land Survey	T46N R1E	J-11
	T R	
	T R	
	T R	
2. Property Controlling in Section	S T R	
	S T R	
3. Miscellaneous Property in Sec.	S T R	
	S T R	
4. Lot No. , Recorded Plat		
5. Private Claims		

\$2.00 HSSR
2/28/1997 3:02:01 PM Receipt #217
RECEIVED FOR RECORD
CHIPPWEA COUNTY - STATE OF MICHIGAN
SHARON H. KENNEDY, REGISTER OF DEEDS

BOOK 9 PAGE 362

Register of Deeds Stamp & File Number

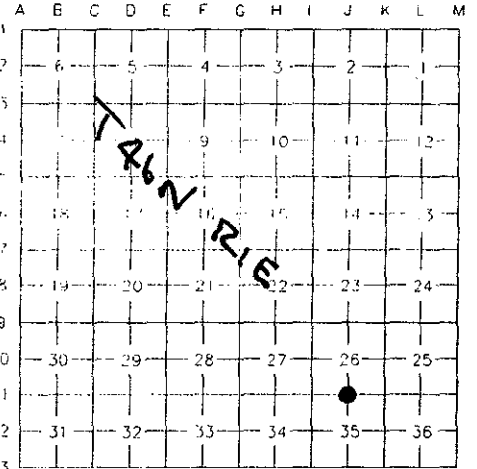

I, William L. Karr, in a field survey on November 11, 1996, do hereby state that under requirements of P.A. 74, Michigan P.A. of 1970, the corner points mentioned in lines 1 and 2 above were in conformance with regulations and rules therefore as required in the current manual of survey instructions of the United States Department of the Interior, Bureau of Land Management or by a decree of a Court of Law and /or that the corner points mentioned in lines 3, 4 and 5 above were in conformance with the rules of the Michigan Board of Land Surveyors or by a Decree of a Court of Law, established, re-established, monumented, recovered, found as expressed below:

NOTE: Not more than 2 corners, all in the same town and range, may be recorded on this certificate.

A. Description of original monument and accessories and/or subsequent restoration:

(J-11) 1/4 Corner Common to Sections 26 & 35, T. 46 N., R. 1 E.

- 1845 J.H. Mullett set post in original survey.
- 1907 F.H. Brown in records in County Surveyors Office show South mile of section 26 as 5347'.
- 1909 F.H. Brown in records in County Surveyors Office for a survey of section 35. Notes mention that there were no 1/4 posts found in this section and the North mile as 5344' and divided up evenly.
- 1993 R. Bischer, PS 22428, in a survey in section 26 shows the South 1/4 corner to be a 1/2" rod. Bischer shows the distance West to the section corner as 2673.90'. Survey recorded in Liber 651, Page 124, Chippewa County records.

B. Description of corner evidence found and/or method applied in restoring or reestablishing corner:

(J-11) 1/4 Corner Common to Sections 26 & 35, T. 46 N., R. 1 E.

This corner is being perpetuated as part of the Chippewa County Remonumentation Program.

Found 1/2" iron with witnesses as noted on Bischer Survey. Position falls 0.8' West, and 1.2' North of being mid-way and on-line between the section corners to the East and West.
Accepted corner position as found.

C. Description of monument for corner and accessories established to perpetuate locating the position of the corner:

(J-11) 1/4 Corner Common to Sections 26 & 35, T. 46 N., R. 1 E.

Corner is a 1/2" iron in a marshy area.

Witnesses:	8" White Birch	S 32° E	20.70'
	10" Spruce	S 10° E	21.48'
	8" Spruce	S 36° W	19.17'
	8" Aspen	S 80° W	8.45'

Bearings are compass bearings, corrected for declination, all distances are to a nail and tag in the side of the witness object unless otherwise noted.

Signed by William L. Karr

Date 12-30-96

Surveyor's Michigan License No. 27450

