

LAND CORNER RECORDATION CERTIFICATE
Filing Requirement of Act 74, Mich. P.A. 1970

For corners in
Chippewa
(County)

Located In: Corner Code ##


- 1. Public Land Survey
T 46N R 1E K-1 Same
T 47N R 1E K-13/Corner
T _____ R _____
T _____ R _____
- 2. Property Controlling in Section
S _____ T _____ R _____
S _____ T _____ R _____
- 3. Miscellaneous Property in Sec.
S _____ T _____ R _____
S _____ T _____ R _____
- 4. Lot No. _____, Recorded Plat _____
- 5. Private Claims _____

RECEIVED FOR RECORD
CHIPPEWA COUNTY
STATE OF MICHIGAN

94 JUL 22 AM 11:16

J. Roger Malott
REGISTER OF DEEDS
Register of Deeds Stamp & File Number

I, Larry R. Rogers, in a field survey on NOVEMBER 3, 19 93, do hereby certify that under requirements of P.A. 74, Michigan P.A. of 1970, the corner points mentioned in lines 1 and 2 above were in conformance with regulations and rules therefore as required in the current manual of survey instructions of the United States Department of the Interior, Bureau of Land Management or by a decree of a Court of Law and/or that the corner points mentioned in lines 3, 4 and 5 above were in conformance with the rules of the Michigan Board of Land Surveyors or by a Decree of a Court of Law; established, re-established, monumented, re-monumented, recovered, found as expressed below:

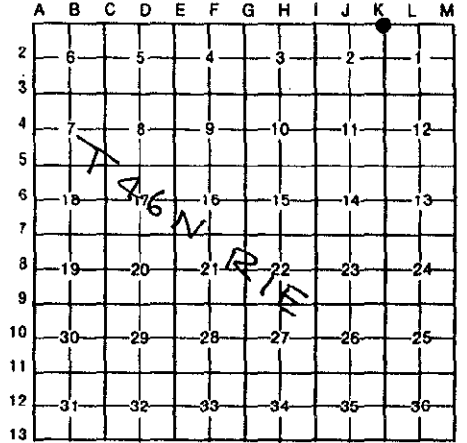

NOTE: Not more than 4 corners, all in the same town and range, may be recorded on this certificate.

- A. Description of original monument and accessories and/or subsequent restoration:
(K-1) Section Corner Common to Sections 16, 17, 20 & 21, T46N-R1E
1840: William A. Burt, set post.
1947-1956: Corner called for in two recorded plats in the area.
1989: L.R. Rogers re-established corner (L.7, P.196) & set a 1/2" iron with cap #29251
- | | | |
|---|-------|--------|
| Concrete Monument (1/2" Iron) | N68°E | 82.11' |
| "V" Notch in 84" C.M.P. | S36°W | 64.30' |
| 4" Diameter Concrete Monument (1/2" Iron) | N66°W | 81.92' |
| 10" Red Pine | N48°W | 61.89' |

- B. Description of corner evidence found and/or method applied in restoring or reestablishing corner:
(K-1) Found corner and all accessories as recorded in Liber 7, Page 196 of the Chippewa County Records. Accepted corner position as found.

SURVEY &
REMONUMENTATION

JUL 26 1994

COMMISSION



- C. Description of monument for corner and accessories established to perpetuate locating the position of the corner:
(K-1) Corner is a 1/2" x 24" iron with L.S. #29251 cap. Falls approximately 3' West of the centerline of Scenic Drive and on the centerline of 6 Mile Road to the West.

Witnesses:

- | | | |
|---|-------|--------|
| Concrete Monument (1/2" Iron) | N68°E | 82.11' |
| "V" Notch in 84" C.M.P. | S36°W | 64.30' |
| 4" Diameter Concrete Monument (1/2" Iron) | N66°W | 81.92' |
| 10" Red Pine | N48°W | 61.89' |

Signed by *[Signature]*
Surveyor's Michigan License No. 29251

Date 20 July 1994

881-00

NOTE: Bearings are compass bearings corrected for declination.
Distances are to a nail in side of witness objects unless noted.