

CHIPPewa COUNTY
REMONUMENTATION

1993

Chippewa County Remonumentation Corner

LAND CORNER RECORDATION CERTIFICATE

Filing Requirement of Act 74, Mich. P.A. 1970

For corners in **COMMISSION**

Chippewa (County)	Located In:	Corner Code #
1. Public Land Survey	T <u>46N</u> R <u>1E</u>	<u>K-7</u>
	T _____ R _____	_____
	T _____ R _____	_____
	T _____ R _____	_____
2. Property Controlling in Section	S _____ T _____ R _____	_____
	S _____ T _____ R _____	_____
3. Miscellaneous Property in Sec.	S _____ T _____ R _____	_____
	S _____ T _____ R _____	_____

RECEIVED FOR RECORD
CHIPPEWA COUNTY
STATE OF MICHIGAN

93 NOV 31 AM 10:48

J. Roger Malott

REGISTER OF DEEDS

Register of Deeds Stamp & File Number

4. Lot No. _____, Recorded Plat _____
5. Private Claims _____

A	B	C	D	E	F	G	H	I	J	K	L	M
2	6	5	4	3	2							
3												
4	7	8	9	10	11	12						
5												
6	16	17	16	15	14	13						
7												
8	19	20	21	22	23	24						
9												
10	30	29	28	27	26	25						
11												
12	31	32	33	34	35	36						
13												

I, Larry R. Rogers, in a field survey on November 9, 19 93, do hereby certify that under requirements of P.A. 74, Michigan P.A. of 1970, the corner points mentioned in lines 1 and 2 above were in conformance with regulations and rules therefore as required in the current manual of survey instructions of the United States Department of the Interior, Bureau of Land Management or by a decree of a Court of Law and/or that the corner points mentioned in lines 3, 4 and 5 above were in conformance with the rules of the Michigan Board of Land Surveyors or by a Decree of a Court of Law; established, re-established, monumented, re-monumented, recovered, found as expressed below:


NOTE: Not more than 4 corners, all in the same town and range, may be recorded on this certificate.

A. Description of original monument and accessories and/or subsequent restoration:

(K-7) Section Corner Common to Sections 13, 14, 23 & 24, T46N-R1E

This corner was previously recorded in 1987 by William L. Karr, P.S. 274500, Liber 6, Page 370 of the Chippewa County Corner Records as a 1/2" iron with the following witnesses:

Corner fence post	N48°E	47.00'
Power pole (DRI/76A4/10)	S32°E	81.37'
Power pole (274/74)	S40°W	82.77'
8" Balsam Fir	N32°W	106.72'

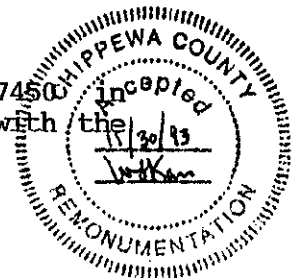

B. Description of corner evidence found and/or method applied in restoring or reestablishing corner:


(K-7) This corner is being perpetuated as part of the Chippewa County Remonumentation Program.

Recovered 1/2" iron with plastic L.S. cap and three of the witnesses from the 1987 records. Witnesses check with corner position. Accepted corner position as found and established one new witness.

C. Description of monument for corner and accessories established to perpetuate locating the position of the corner:

(K-7) Corner is a 1/2" iron with L.S. cap, 4 feet South of centerline of 9 Mile Road and 3 feet West of centerline of Lower Hay Lake Road.

Witnesses: Fence post	N48°E	50.06' (new)
Utility Pole (DRI/76A4/10)	S32°E	81.29'
Utility Pole (274/74)	S40°W	82.71'
9" Balsam Fir	N32°W	106.54'

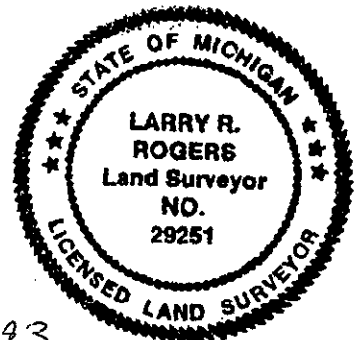

Signed by *Larry R. Rogers* Date 11 Nov 1993
Surveyor's Michigan License No. 29251