

MAY 28 1997

LAND CORNER RECORDATION CERTIFICATE

Filing Requirement of Act 74, Mich. P.A. 1970

Chippewa County Remonumentation Corner #7.00 LAND CORNER

For corners in

Chippewa County	Located in:	Corner Code #
1. Public Land Survey	T46N R1E	K-8
	T R	
	T R	
	T R	
2. Property Controlling in Section	S T R	
	S T R	
3. Miscellaneous Property in Sec.	S T R	
	S T R	
4. Lot No. , Recorded Plat		
5. Private Claims		


\$2.00 MSSR  
 2/28/1997 3:00:49 PM Receipt #217  
 RECEIVED FOR RECORD  
 CHIPPEWA COUNTY - STATE OF MICHIGAN  
 SHARON H. KENNEDY, REGISTER OF DEEDS

BOOK 9 PAGE 361

Register of Deeds Stamp & File Number

I, William L. Karr, in a field survey on December 2, 1996, do hereby state that under requirements of P.A. 74, Michigan P.A. of 1970, the corner points mentioned in lines 1 and 2 above were in conformance with regulations and rules therefore as required in the current manual of survey instructions of the United States Department of the Interior, Bureau of Land Management or by a decree of a Court of Law and /or that the corner points mentioned in lines 3, 4 and 5 above were in conformance with the rules of the Michigan Board of Land Surveyors or by a Decree of a Court of Law, established, re-established, monumented, recovered, found as expressed below:

NOTE: Not more than 2 corners, all in the same town and range, may be recorded on this certificate.

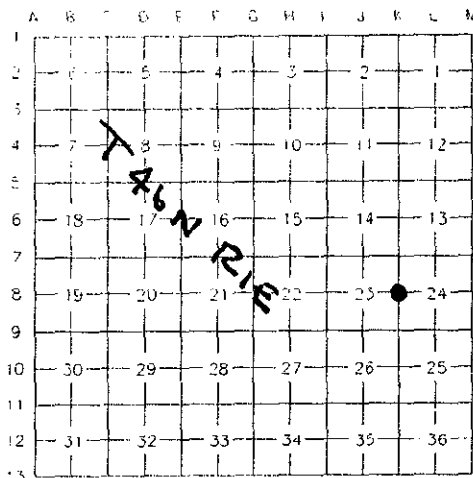

A. Description of original monument and accessories and/or subsequent restoration:

(K-8) 1/4 Corner Common to Sections 23 & 24, T. 46 N., R. 1 E.

- 1845 J.H. Mullett set post in original survey.
- 1901 F.H. Brown in Section Drawing Book in County Surveyors Office shows 1/4 mile distances on the East side of section 23 as 1333'.
- 1909 F.H. Brown in field book in County Surveyors Office, notes that Carleton had previously established section corners to the North and South and mentions no evidence of 1/4 corners.
- 1910 Field book in County Surveyors Office shows the 1/4 mile distances on the West side of section 24 as 1333'.

B. Description of corner evidence found and/or method applied in restoring or reestablishing corner:

(K-8) 1/4 Corner Common to Sections 23 & 24, T. 46 N., R. 1 E.

This corner is being reestablished as part of the Chippewa County Remonumentation Program.

Found no evidence of monument for corner. Found old and well established fence lines East and West from the corner position. Fence lines measure 2666' to the section corner to the South and 2674' to the section corner to the North. Reestablished corner on line between the section corners to the North and South, and on the range of the fences to the East and West.


C. Description of monument for corner and accessories established to perpetuate locating the position of the corner:

(K-8) 1/4 Corner Common to Sections 23 & 24, T. 46 N., R. 1 E.

Corner is a 3/4" x 24" re-bar with plastic Chippewa County Remonumentation Cap. Corner falls in the centerline of a North-South gravel road on the range of fences to the East and West.

Witnesses:	Fence Post	N 48° E	70.63'
	Utility Pole (DR1/76A-4/17)	S 21° E	84.69'
	8" Aspen	N 66° W	45.57'
	12" White Birch	N 25° W	95.81'

Bearings are compass bearings, corrected for declination, all distances are to a nail and tag in the side of the witness object unless otherwise noted.

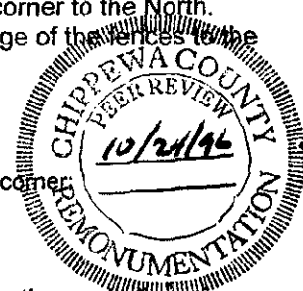

Signed by William L. Karr

Date 12-30-96 BOOK 9 PAGE 361

Surveyor's Michigan License No. 27450