

MAY 28 1997

COMMISSION

LAND CORNER RECORDATION CERTIFICATE
Filing Requirement of Act 74, Mich. P.A. 1970
Chippewa County Remonumentation Corner

For corners in

| | | |
|------------------------------------|---------------|---------------|
| Chippewa County | Located in: | Corner Code # |
| 1. Public Land Survey | T46N R1E | K-11 |
| | T R | |
| | T R | |
| | T R | |
| 2. Property Controlling in Section | S T R | |
| | S T R | |
| 3. Miscellaneous Property in Sec. | S T R | |
| | S T R | |
| 4. Lot No. | Recorded Plat | |
| 5. Private Claims | | |


\$7.00 LAND CORNER

\$2.00 HSSR

2/28/1997 2:57:44 PM Receipt #217
 RECEIVED FOR RECORD
 CHIPPEWA COUNTY - STATE OF MICHIGAN
 SHARON H. KENNEDY, REGISTER OF DEEDS

BOOK 9 PAGE 358

Register of Deeds Stamp & File Number

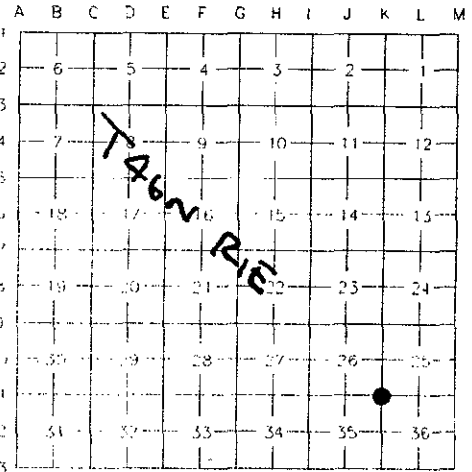

I, William L. Karr, in a field survey on November 29, 1996, do hereby state that under requirements of P.A. 74, Michigan P.A. of 1970, the corner points mentioned in lines 1 and 2 above were in conformance with regulations and rules therefore as required in the current manual of survey instructions of the United States Department of the Interior, Bureau of Land Management or by a decree of a Court of Law and /or that the corner points mentioned in lines 3, 4 and 5 above were in conformance with the rules of the Michigan Board of Land Surveyors or by a Decree of a Court of Law; established, re-established, monumented, recovered, found as expressed below:

NOTE: Not more than 2 corners, all in the same town and range, may be recorded on this certificate.

A. Description of original monument and accessories and/or subsequent restoration:

(K-11) Section Corner Common to Sections 25, 26, 35 & 36, T.46 N., R.1 E.

- 1845 J.H. Mullett set post in original survey.
- 1907 F.H. Brown in field book in County Surveyors Office for a survey in section 35 states that Carleton had set the section corner by dividing up the three miles from the NW corner of section 24, South to the township line.
- 1909 F.H. Brown in field book in County Surveyors Office notes large post for corner and restates that position was established by Carleton.
- 19?? Corner Tie Book in County Surveyor Office shows corner and witnesses.

B. Description of corner evidence found and/or method applied in restoring or reestablishing corner:

(K-11) Section Corner Common to Sections 25, 26, 35 & 36, T.46 N., R.1 E.

This corner is being perpetuated as part of the Chippewa County Remonumentation Program.

Found 1" solid iron in road intersection for corner. Position falls 4.1' West, and at an even split of the three miles as noted by brown in his 1907 survey.
 Accepted corner as found.

C. Description of monument for corner and accessories established to perpetuate locating the position of the corner:

(K-11) Section Corner Common to Sections 25, 26, 35 & 36, T.46 N., R.1 E.

Corner is a 1" solid iron 2' West of centerline Lower Haylake Road and on centerline of 11 Mile Road to East

| | | | |
|------------|---------------|---------|--------|
| Witnesses: | 12" Jack Pine | N 68° E | 81.14' |
| | 14" Jack Pine | S 33° E | 64.93' |
| | 7" Jack Pine | S 59° W | 64.51' |
| | 6" Tamarack | N 65° W | 52.31' |



Bearings are compass bearings, corrected for declination, all distances are to a nail and tag in the side of the witness unless otherwise noted.

Signed by William L. Karr

Date 12-30-96

Surveyor's Michigan License No. 27450