

1993

COMMISSION

Chippewa County Remonumentation Corner

LAND CORNER RECORDATION CERTIFICATE

Filing Requirement of Act 74, Mich. P.A. 1970

For corners in

Chippewa

(County)

Located In:

Corner Code #

1. Public Land Survey	T	46N	R	1E	L-7
	T		R		
	T		R		
	T		R		
2. Property Controlling in Section	S		T	R	
	S		T	R	
3. Miscellaneous Property in Sec.	S		T	R	
	S		T	R	

RECEIVED FOR RECORD
CHIPPEWA COUNTY
STATE OF MICHIGAN

93 NOV 31 AM 10:49

J. Roger Malott

REGISTER OF DEEDS

Register of Deeds Stamp & File Number

- 4. Lot No. _____, Recorded Plat _____
- 5. Private Claims _____

I, Larry R. Rogers, in a field survey on November 9, 1993

do hereby certify that under requirements of P.A. 74, Michigan P.A. of 1970, the corner points mentioned in lines 1 and 2 above were in conformance with regulations and rules therefore as required in the current manual of survey instructions of the United States Department of the Interior, Bureau of Land Management or by a decree of a Court of Law and/or that the corner points mentioned in lines 3, 4 and 5 above were in conformance with the rules of the Michigan Board of Land Surveyors or by a Decree of a Court of Law; established, re-established, monumented, re-monumented, recovered, found as expressed below:

NOTE: Not more than 4 corners, all in the same town and range, may be recorded on this certificate.

A. Description of original monument and accessories and/or subsequent restoration:

(L-7) 1/4 Corner Common to Sections 13 & 24, T46N-R1E

This corner was previously recorded in 1989 by Paul B. Lapham, P.S. 9433, in Liber 700 p. 193 of the Chippewa County Corner Records as a 5/8" iron with the following witnesses.

Fence Corner	North	27.73'
15" Ash	N25°E	54.50'
Power Pole	S30°E	40.30'
18" Ash	N45°E	65.15'

B. Description of corner evidence found and/or method applied in restoring or reestablishing corner:



(L-7) This corner is being perpetuated as part of the Chippewa County Remonumentation Program.

Recovered 5/8" iron in gravel road and recovered four witnesses. Corner position checks with witnesses from 1989 records. Accepted corner as found and established one new witness.

C. Description of monument for corner and accessories established to perpetuate locating the position of the corner:

(L-7) Corner is a 5/8" iron, 1 foot North of centerline of 9 Mile Road.

Witnesses: Corner fence post	N06°E	27.40'
Utility Pole	S30°E	40.24'
15" Ash (Blazed)	N25°E	54.58'
18" Ash (Blazed)	N45°E	65.14'
1/2" Iron	S28°W	35.57'

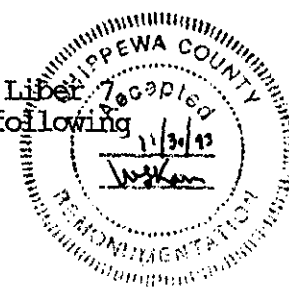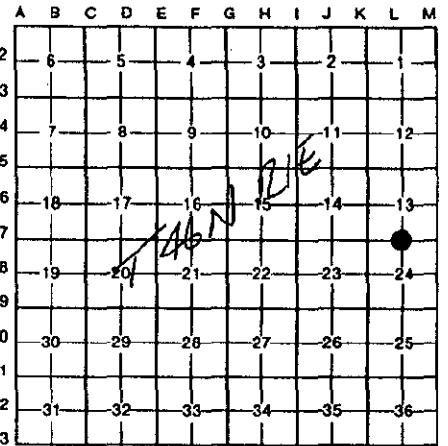

Signed by [Signature] Date 11 Nov 1993

Surveyor's Michigan License No. 29251

NOTE: Bearings are compass bearings corrected for declination. Distances are to a nail in side of witness objects unless noted.