

MAY 28 1997

COMMISSION

LAND CORNER RECORDATION CERTIFICATE

Filing Requirement of Act 74, Mich. P.A. 1970

Chippewa County Remonumentation Corner \$7.00 LAND CORNER


For corners in

Chippewa County	Located in:	Corner Code #
1. Public Land Survey	T46N R1E	L-9
	T R	
	T R	
	T R	
2. Property Controlling in Section	S T R	
	S T R	
3. Miscellaneous Property in Sec	S T R	
	S T R	
4. Lot No.	Recorded Plat	
5. Private Claims		

\$2.00 NSSR
2/28/1997 2:56:09 PM Receipt #217
RECEIVED FOR RECORD
CHIPPewa COUNTY - STATE OF MICHIGAN
SHARON H. KENNEDY, REGISTER OF DEEDS

BOOK 9 PAGE 356

Register of Deeds Stamp & File Number

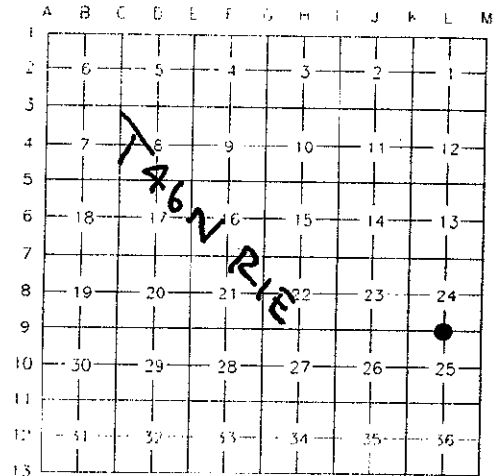

I, William L. Karr, in a field survey on December 2, 1996, do hereby state that under requirements of P.A. 74, Michigan P.A. of 1970, the corner points mentioned in lines 1 and 2 above were in conformance with regulations and rules therefore as required in the current manual of survey instructions of the United States Department of the Interior, Bureau of Land Management or by a decree of a Court of Law and /or that the corner points mentioned in lines 3, 4 and 5 above were in conformance with the rules of the Michigan Board of Land Surveyors or by a Decree of a Court of Law; established, re-established, monumented, recovered, found as expressed below:

NOTE: Not more than 2 corners, all in the same town and range, may be recorded on this certificate.

A. Description of original monument and accessories and/or subsequent restoration:

(L-9) 1/4 Corner Common to Sections 24 & 25, T. 46 N., R. 1 E.

- 1845 J.H. Mullett set post in original survey.
- 1910 F.H. Brown in field book in County Surveyors Office shows the South line of section 24 as being evenly split.
- 1990 W.L. Karr, PS 27450, Northwoods Land Surveying Job 111-544, set North 1/4 corner of section 25. Notes in file show that position was established mid-way between the section corners East and West, and on the centerline of an East-West road.
- 1993 W.L. Karr recorded corner from 1990 survey, Liber 8, Page 253, Chippewa County Corner Records.

B. Description of corner evidence found and/or method applied in restoring or reestablishing corner:

(L-9) 1/4 Corner Common to Sections 24 & 25, T. 46 N., R. 1 E.

This corner is being perpetuated as part of the Chippewa County Remonumentation Program.

Found corner as recorded by Karr in 1993.

Accepted corner as found.



C. Description of monument for corner and accessories established to perpetuate locating the position of the corner:

(L-9) 1/4 Corner Common to Sections 24 & 25, T. 46 N., R. 1 E.

Corner is a 1/2" iron with plastic cap no. 27450 in the centerline of 10 Mile Road. Corner is 0.3' below grade.

Witnesses:	Power Pole (DR1/76A7/7)	N 42° E	45.37'
	10" Spruce	S 46° E	58.16'
	Power Pole	S 24° W	48.46'
	11" Spruce	N 41° W	67.77'

Bearings are compass bearings, corrected for declination, all distances are to a nail and tag in the side of the witness object unless otherwise noted.



Signed by William L. Karr

Date 12-30-96

Surveyor's Michigan License No. 27450