

SURVEY & REMONUMENTATION

APR 27 1995

CHIPPEWA COUNTY REMONUMENTATION CORNER

LAND CORNER RECORDATION CERTIFICATE

Filing Requirement of Act 74, Mich. P.A. 1970

COMMISSION

For corners in

Chippewa

(County)

Located In:

Corner Code #

1. Public Land Survey	T	46N	R	1W	A-3	same
	T	46N	R	2W	M-3	corner
	T		R			
	T		R			
2. Property Controlling in Section	S		T	R		
	S		T	R		
3. Miscellaneous Property in Sec.	S		T	R		
	S		T	R		

\$ 7.00 LAND CORNER
 \$ 2.00 MSSR
 19 DEC 94 10:20 A.M. RECEIPT# 1769
 RECEIVED FOR RECORD
 CHIPPEWA COUNTY - STATE OF MICHIGAN
 SHARON H. KENNEDY, REGISTER OF DEEDS
Register of Deeds Stamp & File Number


4. Lot No. _____, Recorded Plat _____
 5. Private Claims _____

I, William L. Karr, in a field survey on November 10, 1994, do hereby certify that under requirements of P.A. 74, Michigan P.A. of 1970, the corner points mentioned in lines 1 and 2 above were in conformance with regulations and rules therefore as required in the current manual of survey instructions of the United States Department of the Interior, Bureau of Land Management or by a decree of a Court of Law and/or that the corner points mentioned in lines 3, 4 and 5 above were in conformance with the rules of the Michigan Board of Land Surveyors or by a Decree of a Court of Law; established, re-established, monumented, re-monumented, recovered, found as expressed below:

NOTE: Not more than 4 corners, all in the same town and range, may be recorded on this certificate.

A. Description of original monument and accessories and/or subsequent restoration:

(A-3) Section Corner 6 & 7, T.46 N., R.1 W. (Section Corner 1 & 12, T.46 N., R.2 W.)
 1840: Austin Burt set post Fir 5 S08W 26 lks Tamarack 10 N56W 1 lks
 1845: J. Mullett Spruce 12 S42E 10 lks Spruce 14 N57E 26 lks

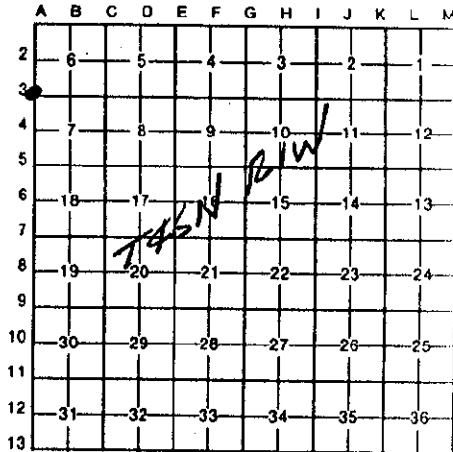

B. Description of corner evidence found and/or method applied in restoring or reestablishing corner:

(A-3) This corner is being perpetuated as part of the Chippewa County Remonumentation program.

Found no evidence of original corner. Found a 4" diameter concrete monument in a 5" diameter steel pipe. Monument has "Chippewa County Corner" brass cap. Do not know the origin of the monument but is typical of those set in the late 1930's or early 1940's. There are fences at the 1/4 lines and South 1/16th lines in both Section 6 and Section 1. The South 1/16th line fences are very nearly on an even split between the 1/4 line fences and this monument. Accepted the monument as the best available evidence and witnessed.

C. Description of monument for corner and accessories established to perpetuate locating the position of the corner:

(A-3) Corner is a 4" diameter concrete monument with "Chippewa County" brass cap. Corner is under 6" of mud and water (11/10/94).

Witnesses: 4" Balsam Fir	N40°E	39.94'
6" W. Birch	S52°E	12.24'
4" Twin Spruce	S30°W	36.87'
10" Tamarack	N88°W	36.65'



Signed by William L. Karr Date 12/8/94

Surveyor's Michigan License No. 27450

723-12

NOTE: Bearings are compass bearings corrected for declination.
 Distances are to a nail in side of witness objects unless noted.