

**SURVEY & REMONUMENTATION**

**CHIPPEWA COUNTY REMONUMENTATION CORNER**

APR 27 1995

**LAND CORNER RECORDATION CERTIFICATE**

Filing Requirement of Act 74, Mich. P.A. 1970

For corner of **COMMISSION**

Chippewa

(County)

Located In:


Corner Code ##

- |                                       |                          |                   |
|---------------------------------------|--------------------------|-------------------|
| 1. Public Land Survey                 | T <u>46N</u> R <u>1W</u> | <u>A-4</u> same   |
|                                       | T <u>46N</u> R <u>2W</u> | <u>M-4</u> corner |
|                                       | T _____ R _____          | _____             |
|                                       | T _____ R _____          | _____             |
| 2. Property Controlling in Section    | S _____ T _____ R _____  | _____             |
|                                       | S _____ T _____ R _____  | _____             |
| 3. Miscellaneous Property in Sec.     | S _____ T _____ R _____  | _____             |
|                                       | S _____ T _____ R _____  | _____             |
| 4. Lot No. _____, Recorded Plat _____ |                          |                   |
| 5. Private Claims _____               |                          |                   |

\$ 7.00 LAND CORNER  
 \$ 2.00 MSSR  
 19 DEC 94 10:21 A.M. RECEIPT# 1769  
 RECEIVED FOR RECORD  
 CHIPPEWA COUNTY - STATE OF MICHIGAN  
 SHARON H. KENNEDY, REGISTER OF DEEDS  
 Register of Deeds Stamp & File Number

I, William L. Karr, in a field survey on November 10, 19 94, do hereby certify that under requirements of P.A. 74, Michigan P.A. of 1970, the corner points mentioned in lines 1 and 2 above were in conformance with regulations and rules therefore as required in the current manual of survey instructions of the United States Department of the Interior, Bureau of Land Management or by a decree of a Court of Law and/or that the corner points mentioned in lines 3, 4 and 5 above were in conformance with the rules of the Michigan Board of Land Surveyors or by a Decree of a Court of Law; established, re-established, monumented, re-monumented, recovered, found as expressed below:

**NOTE: Not more than 4 corners, all in the same town and range, may be recorded on this certificate.**

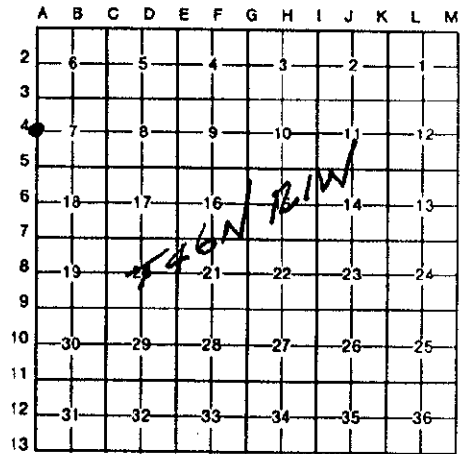

A. Description of original monument and accessories and/or subsequent restoration:

(A-4) 1/4 Corner Section 7, T.46 N., R.1 W. and Section 12, T.46 N., R.2 W.

1840: A. Burt set post Tamarack 7 S35W 25 lks  
 Tamarack 17 N10W 10 lks

1921: County Surveyor notes show a distance on the West side of Section 7 as 5290'.


1924: County Surveyor notes show a distance on the East side of Section 12 as 5302'. It appears that these measurements were to fences or grades.

B. Description of corner evidence found and/or method applied in restoring or reestablishing corner:

(A-4) This corner is being re-established as part of the Chippewa County Remonumentation program.

Found no evidence of original corner. Reconstructed corner position from existing East-West 1/4 line fences in Sections 7 & 12 and the right-of-way fences for abandoned Townline Road.

Re-established position measures 2653.06' to the Section Corner to the North and 2653.95' to the Section Corner to the South.

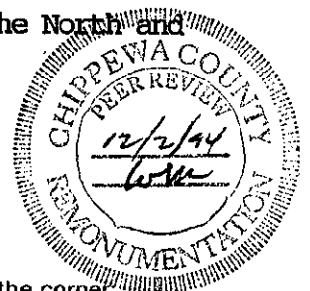

C. Description of monument for corner and accessories established to perpetuate locating the position of the corner.

(A-4) Corner is a 3/4"x 24" iron with aluminum "Chippewa County Remonumentation" cap on the extension of fencelines to the East and West.

Witnesses: 12" Balsam Fir  
 1" pipe w/Chippewa County cap  
 1" pipe w/mushroom top  
 10" Balsam Fir

N11°E 140.25'  
 East 29.91'  
 West 30.24'  
 N15°W 169.24'



Signed by William L. Karr

Date 12/8/94

Surveyor's Michigan License No. 27450

723-12

NOTE: Bearings are compass bearings corrected for declination.  
 Distances are to a nail in side of witness objects unless noted.