

**SURVEY &
REMONUMENTATION**

CHIPPEWA COUNTY REMONUMENTATION CORNER

APR 27 1995

LAND CORNER RECORDATION CERTIFICATE
Filing Requirement of Act 74, Mich. P.A. 1970

For corners in **COMMISSION**
Chippewa
(County)

Located In: Corner Code #

- | | | |
|---------------------------------------|--------------------------|-------------------|
| 1. Public Land Survey | T <u>46N</u> R <u>1W</u> | <u>A-6</u> same |
| | T <u>46N</u> R <u>2W</u> | <u>M-6</u> corner |
| | T _____ R _____ | _____ |
| | T _____ R _____ | _____ |
| 2. Property Controlling in Section | S _____ T _____ R _____ | _____ |
| | S _____ T _____ R _____ | _____ |
| 3. Miscellaneous Property in Sec. | S _____ T _____ R _____ | _____ |
| | S _____ T _____ R _____ | _____ |
| 4. Lot No. _____, Recorded Plat _____ | | |
| 5. Private Claims _____ | | |

\$ 7.00 LAND CORNER
\$ 2.00 HSSR
19 DEC 94 10:21 A.M. RECEIPT# 1769
RECEIVED FOR RECORD
CHIPPEWA COUNTY - STATE OF MICHIGAN
SHARON H. KENNEDY, REGISTER OF DEEDS
Register of Deeds Stamp & File Number

I, William L. Karr, in a field survey on November 10, 19 94, do hereby certify that under requirements of P.A. 74, Michigan P.A. of 1970, the corner points mentioned in lines 1 and 2 above were in conformance with regulations and rules therefore as required in the current manual of survey instructions of the United States Department of the Interior, Bureau of Land Management or by a decree of a Court of Law and/or that the corner points mentioned in lines 3, 4 and 5 above were in conformance with the rules of the Michigan Board of Land Surveyors or by a Decree of a Court of Law; established, re-established, monumented, re-monumented, recovered, found as expressed below:

A	B	C	D	E	F	G	H	I	J	K	L	M
2	6	5	4	3	2	1						
3												
4	7	8	9	10	11	12						
5												
6	13	17	16	15	14	13						
7												
8	19	20	21	22	23	24						
9												
10	30	29	28	27	26	25						
11												
12	31	32	33	34	35	36						
13												


NOTE: Not more than 4 corners, all in the same town and range, may be recorded on this certificate.

A. Description of original monument and accessories and/or subsequent restoration:

- (A-6) 1/4 Corner Section 18, T.46 N., R.1 W. and Section 13, T.46 N., R.2 W.
1840: Austin Burt set post Spruce 6 S29W 44 lks
Tamarack 8 N70W 14 lks
1915: County Surveyor notes show a distance on the West side of Section 18 measuring 5266'
 ? County Surveyor notes from the early 1900's show the East side of Section 13 measuring 5244. This appears to be measurements to fences and grades.

B. Description of corner evidence found and/or method applied in restoring or reestablishing corner:

- (A-6) This corner is being re-established as part of the Chippewa County Remonumentation program.
 Found no evidence of original corner. Re-established corner on a straight line between the Section corners to the North and South and on the extension of a very old fenceline to the East. Distance for the North 1/2 mile is 2653.44'. Distance for the South 1/2 mile is 2525.04'.

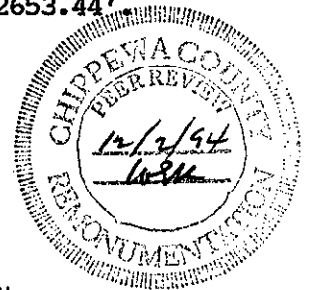

C. Description of monument for corner and accessories established to perpetuate locating the position of the corner:

- (A-6) Corner is a 3/4"x 24" iron with plastic "Chippewa County Remonumentation" cap, 4' West of the centerline of Townline Road and on the extension of an old fenceline to the East.
 Witnesses: Wood fence post N79°E 52.32'
 1/2" iron on R.O.W. fence East 50.93'
 P. Pole S20°W 201.05'
 P. Pole N26°W 110.09'



Signed by William L. Karr Date 12/8/94

Surveyor's Michigan License No. 27450 723-12

NOTE: Bearings are compass bearings corrected for declination.
Distances are to a nail in side of witness objects unless noted.