

**SURVEY &
REMONUMENTATION**

CHIPPEWA COUNTY REMONUMENTATION CORNER

APR 27 1995

LAND CORNER RECORDATION CERTIFICATE

Filing Requirement of Act 74, Mich. P.A. 1970

For corner of **COMMISSION**

Chippewa
(County)

Located In:


Corner Code #

- | | | |
|------------------------------------|--------------------------|-------------------|
| 1. Public Land Survey | T <u>46N</u> R <u>1W</u> | <u>A-9</u> same |
| | T <u>46N</u> R <u>2W</u> | <u>M-9</u> corner |
| | T _____ R _____ | _____ |
| | T _____ R _____ | _____ |
| 2. Property Controlling in Section | S _____ T _____ R _____ | _____ |
| | S _____ T _____ R _____ | _____ |
| 3. Miscellaneous Property in Sec. | S _____ T _____ R _____ | _____ |
| | S _____ T _____ R _____ | _____ |

\$ 7.00 LAND CORNER
\$ 2.00 HSSR
19 DEC 94 10:22 A.M. RECEIPT# 1769
RECEIVED FOR RECORD
CHIPPEWA COUNTY - STATE OF MICHIGAN
RECORDS OF LAND SURVEYING DEPARTMENT

4. Lot No. _____, Recorded Plat _____
5. Private Claims _____

I, William L. Karr, in a field survey on November 10, 19 94, do hereby certify that under requirements of P.A. 74, Michigan P.A. of 1970, the corner points mentioned in lines 1 and 2 above were in conformance with regulations and rules therefore as required in the current manual of survey instructions of the United States Department of the Interior, Bureau of Land Management or by a decree of a Court of Law and/or that the corner points mentioned in lines 3, 4 and 5 above were in conformance with the rules of the Michigan Board of Land Surveyors or by a Decree of a Court of Law; established, re-established, monumented, re-monumented, recovered, found as expressed below:

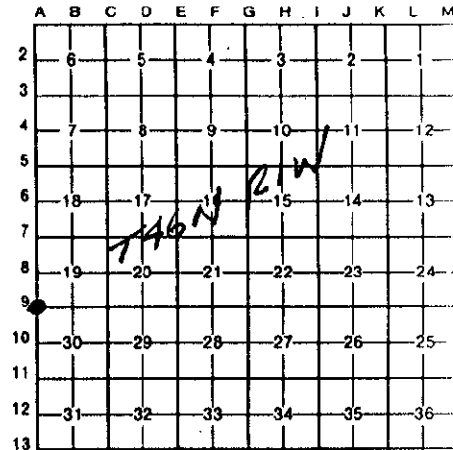

NOTE: Not more than 4 corners, all in the same town and range, may be recorded on this certificate.

A. Description of original monument and accessories and/or subsequent restoration:

- (A-9) Section Corner 19 & 30, T.46 N., R.1 W. (Section Corner 24 & 25, T.46 N., R.2 W.)
1840: Austin Burt set post Spruce 14 S57W 21 lks Swamp Oak 44 North 10 lks
1845: J. Mullett Maple 12 S83W 39 Birch 12 N22E 62 lks
1988: W.L. Karr found a concrete monument, 24" below grade and accepted as found. Set a 1/2"x 18" iron w/cap No.27450 at road surface.
 Corner is recorded in L.07, P.314 of corner records.

B. Description of corner evidence found and/or method applied in restoring or reestablishing corner:

(A-9) This corner is being perpetuated as part of the Chippewa County Remonumentation program.
 Found no evidence of original corner. Found 1/2" iron with cap No. 27450. Based on past use and existing concrete monument below the iron, accepted corner position as found.



C. Description of monument for corner and accessories established to perpetuate locating the position of the corner:

(A-9) Corner is a 1/2" iron with cap No. 27450 over an old concrete monument.

Witnesses: Corner fence post	N19°E	53.11'
P. Pole (DR4/75/18)	S13°W	138.07'
P. Pole (DR4/75/17)	S30°W	53.49'
Center Telephone Box	N41°W	60.35'



Signed by W.L. Karr Date 12/8/94

Surveyor's Michigan License No. 27450

723-12

NOTE: Bearings are compass bearings corrected for declination.
Distances are to a nail in side of witness objects unless noted.