

**SURVEY & REMONUMENTATION**  
**CHIPPEWA COUNTY REMONUMENTATION CORNER**

APR 27 1995

**LAND CORNER RECORDATION CERTIFICATE**  
**Filing Requirement of Act 74, Mich. P.A. 1970**

For corners in Chippewa **COMMISSION**  
(County)

Located In: \_\_\_\_\_ Corner Code A-11

- |                                    |   |            |   |           |                    |
|------------------------------------|---|------------|---|-----------|--------------------|
| 1. Public Land Survey              | T | <u>46N</u> | R | <u>1W</u> | <u>A-11</u> same   |
|                                    | T | <u>46N</u> | R | <u>2W</u> | <u>M-11</u> corner |
|                                    | T | _____      | R | _____     | _____              |
|                                    | T | _____      | R | _____     | _____              |
| 2. Property Controlling in Section | S | _____      | T | _____     | _____              |
|                                    | S | _____      | T | _____     | _____              |
| 3. Miscellaneous Property in Sec.  | S | _____      | T | _____     | _____              |
|                                    | S | _____      | T | _____     | _____              |
4. Lot No. \_\_\_\_\_, Recorded Plat \_\_\_\_\_
5. Private Claims \_\_\_\_\_

\$ 7.00 LAND CORNER  
 \$ 2.00 HSSR  
 19 DEC 94 10:22 A.M. RECEIPT# 1769  
 RECEIVED FOR RECORD  
 CHIPPEWA COUNTY - STATE OF MICHIGAN  
 SHARON H. KENNEDY, REGISTER OF DEEDS

Register of Deeds Stamp & File Number

I, William L. Karr, in a field survey on November 10, 19 94, do hereby certify that under requirements of P.A. 74, Michigan P.A. of 1970, the corner points mentioned in lines 1 and 2 above were in conformance with regulations and rules therefore as required in the current manual of survey instructions of the United States Department of the Interior, Bureau of Land Management or by a decree of a Court of Law and/or that the corner points mentioned in lines 3, 4 and 5 above were in conformance with the rules of the Michigan Board of Land Surveyors or by a Decree of a Court of Law; established, re-established, monumented, re-monumented, recovered, found as expressed below:

**NOTE: Not more than 4 corners, all in the same town and range, may be recorded on this certificate.**

A	B	C	D	E	F	G	H	I	J	K	L	M
2	6	5	4	3	2	1						
3												
4	7	8	9	10	11	12						
5												
6	18	17	16	15	14	13						
7												
8	19	20	21	22	23	24						
9												
10	30	29	28	27	26	25						
11												
12	31	32	33	34	35	36						
13												

A. Description of original monument and accessories and/or subsequent restoration:

(A-11) Section Corner 30 & 31, T.46 N., R.1 W. (Section Corner 25 & 36, T.46 N., R.2 W.)  
1840: Austin Burt set post Cedar 12 S49W 22 lks Fir 12 N70W 11 lks  
1845: J. Mullett Fir 12 S33E 27 lks Birch 10 N69E 38 lks

B. Description of corner evidence found and/or method applied in restoring or reestablishing corner:



(A-11) This corner is being perpetuated as part of the Chippewa County Remonumentation program.

Found no evidence of original corner. Found an old concrete monument with a thin strand of wire in the center. This type of monument was set in the late 1920's or early 1930's. This monument works well with 1/4 line fences to the North and South. I accepted the position as found.

C. Description of monument for corner and accessories established to perpetuate locating the position of the corner:

(A-11) Corner is a 3" diameter concrete monument with a 1/8" wire in the center. The corner falls in the centerline of Townline Road (gravel) and 11 mile Road (Gravel).

Witnesses: Center telephone box	N51°E 43.82'
Wood post	S47°E 41.39'
Corner fence post	S59°W 55.13'
P. Pole (DR4/75/34)	N41°W 40.83'

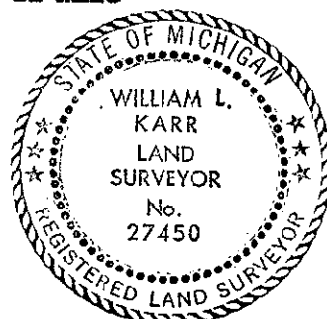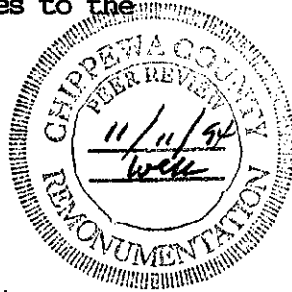

Signed by William L. Karr Date 12/8/94

Surveyor's Michigan License No. 27450

723-12

NOTE: Bearings are compass bearings corrected for declination.  
 Distances are to a nail in side of witness objects unless noted.