

**SURVEY & REMONUMENTATION**

APR 27 1995

CHIPPEWA COUNTY REMONUMENTATION CORNER

COMMISSION

LAND CORNER RECORDATION CERTIFICATE  
Filing Requirement of Act 74, Mich. P.A. 1970

For corners in

Chippewa  
(County)

Located In:

Corner Code #

- 1. Public Land Survey T 46N R 1W  
T 46N R 2W  
T \_\_\_\_\_ R \_\_\_\_\_  
T \_\_\_\_\_ R \_\_\_\_\_
- 2. Property Controlling S \_\_\_\_\_ T \_\_\_\_\_ R \_\_\_\_\_  
in Section S \_\_\_\_\_ T \_\_\_\_\_ R \_\_\_\_\_
- 3. Miscellaneous S \_\_\_\_\_ T \_\_\_\_\_ R \_\_\_\_\_  
Property in Sec. S \_\_\_\_\_ T \_\_\_\_\_ R \_\_\_\_\_


A-12 same  
M-12 corner

\$ 7.00 LAND CORNER  
\$ 2.00 MSSR  
19 DEC 94 10:23 A.M. RECEIPT# 1769  
RECEIVED FOR RECORD  
CHIPPEWA COUNTY - STATE OF MICHIGAN  
SHARON H. KENNEDY, REGISTER OF DEEDS  
Register of Deeds Stamp & File Number

- 4. Lot No. \_\_\_\_\_, Recorded Plat \_\_\_\_\_
- 5. Private Claims \_\_\_\_\_

I, William L. Karr, in a field survey on November 10, 19 94, do hereby certify that under requirements of P.A. 74, Michigan P.A. of 1970, the corner points mentioned in lines 1 and 2 above were in conformance with regulations and rules therefore as required in the current manual of survey instructions of the United States Department of the Interior, Bureau of Land Management or by a decree of a Court of Law and/or that the corner points mentioned in lines 3, 4 and 5 above were in conformance with the rules of the Michigan Board of Land Surveyors or by a Decree of a Court of Law; established, re-established, monumented, re-monumented, recovered, found as expressed below:

**NOTE: Not more than 4 corners, all in the same town and range, may be recorded on this certificate.**

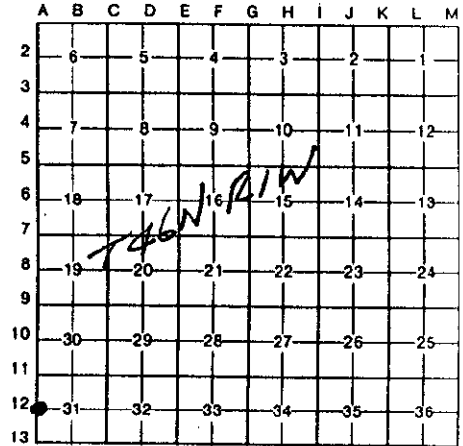

A. Description of original monument and accessories and/or subsequent restoration:

(A-12) 1/4 Corner Section 31, T.46 N., R.1 W. and Section 36, T.46 N., R.2 W.

1840: Austin Burt set post B. Ash 6 S50W 20 lks  
B. Ash 6 N68W 20 lks

1899: County Surveyor notes show the North and South 1/2 miles as measuring 2633' (2636.18' today).

B. Description of corner evidence found and/or method applied in restoring or reestablishing corner:

(A-12) This corner is being re-established as part of the Chippewa County Remonumentation program.

Found no evidence of original corner. Re-established corner mid-way and on-line between the Section corner to the North and the Section corner to the South.  
Re-established corner falls on fencelines to the East and West.



C. Description of monument for corner and accessories established to perpetuate locating the position of the corner:

(A-12) Corner is a 3/4"x 24" iron with plastic "Chippewa County Remonumentation" cap, 9' West of the centerline of Townline Road (gravel) and on the extension of fences to the East and West.

Witnesses: East end of 24" cmp("v" notch) N85°E 34.73'  
Fence Post S88°E 283.42'  
P. Pole S20°W 89.96'  
West end of 24" cmp("v" notch) N64°W 12.79'



Signed by William L. Karr Date 12/8/94

Surveyor's Michigan License No. 27450

NOTE: Bearings are compass bearings corrected for declination.  
Distances are to a nail in side of witness objects unless noted.