

SURVEY & REMONUMENTATION

MAY 28 1997 **CHIPPEWA COUNTY REMONUMENTATION CORNER**


COMMISSION

LAND CORNER RECORDATION CERTIFICATE
Filing Requirement of Act 74, Mich. P.A. 1970

For corners in

Chippewa Located In: Corner Code #
(County)

- 1. Public Land Survey T46N R 1W B-5
T___ R___
T___ R___
T___ R___
- 2. Property Controlling in Section S___ T___ R___
S___ T___ R___
- 3. Miscellaneous Property in Sec. S___ T___ R___
S___ T___ R___

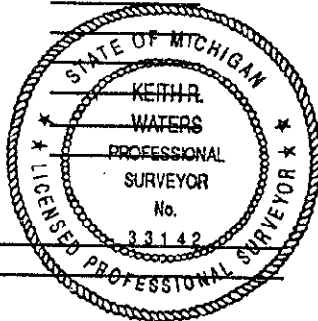

\$7.00 LAND CORNER
\$2.00 MSSR
2/28/1997 4:15:15 PM Receipt #226
RECEIVED FOR RECORD
CHIPPEWA COUNTY - STATE OF MICHIGAN
SHARON H. KENNEDY, REGISTER OF DEEDS

BOOK 9 PAGE 390

Register of Deeds Stamp & File Number

- 4. Lot No. _____, Recorded Plat _____
- 5. Private Claims _____

I, Keith R. Waters, in a field survey on 12/03, 1996 do hereby state that under requirements of P.A. 74, Michigan P.A. of 1970, the corner points mentioned in lines 1 and 2 above were in conformance with regulations and rules therefore as required in the current manual of survey instructions of the United States Department of the Interior, Bureau of Land Management or by a decree of a Court of Law and /or that the corner points mentioned in lines 3, 4 and 5 above were in conformance with the rules of the Michigan Board of Land Surveyors or by a Decree of a Court of Law; established, re-established, monumented, recovered, found as expressed below:

	A	B	C	D	E	F	G	H	I	J	K	L	M
1													
2	6		5		4		3		2		1		
3													
4	7		8		9		10		11		12		
5	●												
6	18		17		16		15		14		13		
7													
8	19		20		21		22		23		24		
9													
10	30		29		28		27		26		25		
11													
12	31		32		33		34		35		36		
13													

NOTE: Not more than 2 corners, all in the same town and range, may be recorded on this certificate.

A. Description of original monument and accessories and/or subsequent restoration:

B-5 1/4 Corner Common to Sections 7 & 18, Town 46 North, Range 1 West
1845 - Original ties (James Mullett): Spruce 12, S34°W 29 links - Spruce 6, N40°W 18 links.
1905 - County Surveyor Frederick H. Brown notes indicate this 1/4 corner between section corners 2594 feet to the east and 2462 feet to the west. This appears to a pro-rated position with the original GLO notes, which showed 2640 feet east and 2508 feet west. Brown also notes that the west line of Section 7 was run by former County Surveyor Murphy for the purpose of a road. He states that Murphy "got things all tangled up and made a mess of the whole thing."


B. Description of corner evidence found and/or method applied in restoring or reestablishing corner:

This corner is being re-established as part of the Chippewa County Remonumentation Program. Found no evidence of the corner location. The corner on the range line between Sections 7 and 18 is a previously accepted Remonumentation corner. It was determined that the accepted corner is based on the erroneous Murphy survey as mentioned above, and is approximately 120 feet east of the probable original corner location. I re-established the 1/4 corner B-5 on line between the recorded position of section corner A-5 and section corner C-5. However, the recorded position at A-5 was not used to establish the east-west position of 1/4 corner B-5, since that would be perpetuating the known error of the Murphy survey. The east-west position of 1/4 corner was pro-rated according to GLO notes between section corner C-5 and the straight line between original corners on the range line at A-3 and A-7. This results in a distance between B-5 and C-5 that is within approximately 9 feet of the GLO distance.

C. Description of monument for corner and accessories established to perpetuate locating the position of the corner:

Corner is a 3/4" x 24" rebar with a stamped aluminum Chippewa County Remonumentation cap in a wooded area, approximately 100 feet south of the south edge of a large cultivated field. Witnesses:
7" Poplar, N33°E 29.86'
3" Poplar, S67°W 26.13'
3" Poplar, S06°W 15.70'
7" Poplar, S50°E 31.36'

Note: Unless noted otherwise, distances are to a nail/tag #33142 in the side of the witness object. Bearings are compass bearings corrected for declination. Trees are blazed.

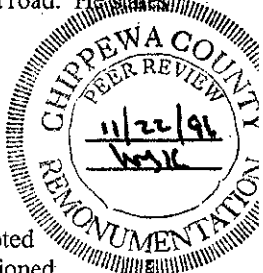

Signed by Keith R. Waters
Surveyor's Michigan License No. 33142

Date 12-30-96

BOOK 9 PAGE 390