

SURVEY & REMONUMENTATION

CHIPPEWA COUNTY REMONUMENTATION CORNER

APR 27 1995

LAND CORNER RECORDATION CERTIFICATE
Filing Requirement of Act 74, Mich. P.A. 1970


For corners in **CHIPPEWA**
Chippewa
(County)

	Located In:	Corner Code #
1. Public Land Survey	T <u>46N</u> R <u>1W</u>	<u>B-7</u>
	T _____ R _____	_____
	T _____ R _____	_____
	T _____ R _____	_____
2. Property Controlling in Section	S _____ T _____ R _____	_____
	S _____ T _____ R _____	_____
3. Miscellaneous Property in Sec.	S _____ T _____ R _____	_____
	S _____ T _____ R _____	_____

\$ 7.00 LAND CORNER
\$ 2.00 MSSR
19 DEC 94 10:16 A.M. RECEIPT# 1769
RECEIVED FOR RECORD
CHIPPEWA COUNTY - STATE OF MICHIGAN
SHARON H. KENNEDY, REGISTER OF DEEDS

Register of Deeds Stamp & File Number


4. Lot No. _____, Recorded Plat _____
5. Private Claims _____

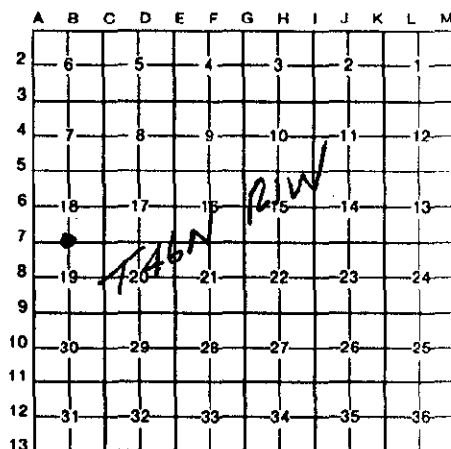

I, William L. Karr, in a field survey on October 19, 1994, do hereby certify that under requirements of P.A. 74, Michigan P.A. of 1970, the corner points mentioned in lines 1 and 2 above were in conformance with regulations and rules therefore as required in the current manual of survey instructions of the United States Department of the Interior, Bureau of Land Management or by a decree of a Court of Law and/or that the corner points mentioned in lines 3, 4 and 5 above were in conformance with the rules of the Michigan Board of Land Surveyors or by a Decree of a Court of Law; established, re-established, monumented, re-monumented, recovered, found as expressed below:

NOTE: Not more than 4 corners, all in the same town and range, may be recorded on this certificate.

A. Description of original monument and accessories and/or subsequent restoration:
(B-7) 1/4 Corner common to Sections 18 & 19, T.46 N., R.1 W.
1845: J. Mullett marked a Spruce 12 for 1/4 section corner
1912: County Survey notes show the East 1/2 mile as 2640 and the West 1/2 Mile as 2610

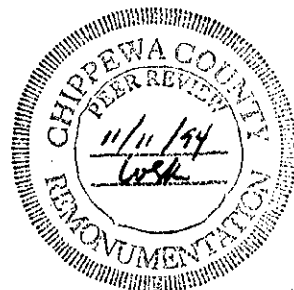

B. Description of corner evidence found and/or method applied in restoring or reestablishing corner:
(B-7) This corner is being re-established as part of the Chippewa County Remonumentation program.
Found no evidence of original corner. Total measurement for this section line is 5231.50' (GLO is 5248.32'). There is a 1/4 line fence to the North in Section 18. Distance West to the Township corner is 2598.33' (GLO pro-rated is 2599.94'), distance East to Section corner 17, 18, 19 & 20 is 2633.17' (GLO pro-rated is 2631.54). I re-established the 1/4 corner on a straight line between Section corners on the extension of the fenceline to the North.

C. Description of monument for corner and accessories established to perpetuate locating the position of the corner:
(B-7) Corner is a 3/4"x 24" iron with plastic "Chippewa County Remonumentation" cap, on the extension of a fenceline to the North and 5.2' North of the centerline of M-28.

Witnesses: Fence post	N10°E	70.58'
P. Pole (DR4/65)	S33°E	76.05'
"v" notch in 30" cmp	S60°W	60.04'
Fence post	N08°W	72.20'



Signed by William L. Karr Date 12/7/94
Surveyor's Michigan License No. 27450

723-12