

MAY 28 1997

COMMISSION

CHIPPEWA COUNTY REMONUMENTATION CORNER

LAND CORNER RECORDATION CERTIFICATE
Filing Requirement of Act 74, Mich. P.A. 1970

For corners in

Chippewa _____ Located In: _____ Corner Code # _____
(County)

- 1. Public Land Survey T 46N R 1W B-9 _____
T _____ R _____
T _____ R _____
T _____ R _____
- 2. Property Controlling in Section S _____ T _____ R _____
S _____ T _____ R _____
- 3. Miscellaneous S _____ T _____ R _____
Property in Sec. S _____ T _____ R _____



- 4. Lot No. _____, Recorded Plat _____
- 5. Private Claims _____

\$7.00 LAND CORNER

\$2.00 MSSR
2/28/1997 4:16:36 PM Receipt #226
RECEIVED FOR RECORD
CHIPPEWA COUNTY - STATE OF MICHIGAN
SHARON H. KENNEDY, REGISTER OF DEEDS

BOOK 9 PAGE 391
Register of Deeds Stamp & File Number

I, Keith R. Waters, in a field survey on 11/12, 1996 do hereby state that under requirements of P.A. 74, Michigan P.A. of 1970, the corner points mentioned in lines 1 and 2 above were in conformance with regulations and rules therefore as required in the current manual of survey instructions of the United States Department of the Interior, Bureau of Land Management or by a decree of a Court of Law and /or that the corner points mentioned in lines 3, 4 and 5 above were in conformance with the rules of the Michigan Board of Land Surveyors or by a Decree of a Court of Law; established, re-established, monumented, recovered, found as expressed below:

NOTE: Not more than 2 corners, all in the same town and range, may be recorded on this certificate.


	A	B	C	D	E	F	G	H	I	J	K	L	M
1													
2		6		5		4		3		2		1	
3													
4		7		8		9		10		11		12	
5													
6		18		17		16		15		14		13	
7													
8		19		20		21		22		23		24	
9		●											
10		30		29		28		27		26		25	
11													
12		31		32		33		34		35		36	
13													

A. Description of original monument and accessories and/or subsequent restoration:

B-9 1/4 Corner Common to Sections 19 & 30, Town 46 North, Range 1 West
1845 - Original ties (James Mullett): Cedar 8, S70°W 13 links - Cedar 8, N52°W 21 links.
1891, 1912 - County Surveyor Frederick H. Brown notes for Sections 19 and 30 suggest that no evidence of the original corner location could be found at that time. A variety of distances between section corners east and west are shown. (5236 feet, 5275 feet, and 5245 feet).

B. Description of corner evidence found and/or method applied in restoring or reestablishing corner:

This corner is being re-established as part of the Chippewa County Remonumentation Program.
Found no evidence of corner. Re-established corner by single proportionate measurement according to the original GLO notes between section corners 2624.07 feet east and 2610.95 feet west. Corner falls in the centerline of an east-west gravel road (10 Mile Road), on the extension of a fence line to the south, 4 feet east of a fence line to the north. Position is also within 0.5 feet a fence at the west 1/4 line of Section 19.

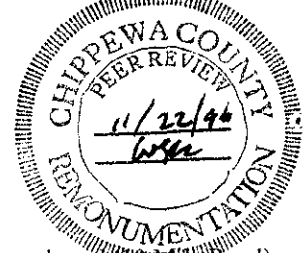

C. Description of monument for corner and accessories established to perpetuate locating the position of the corner:

Corner is a 3/4" x 24" rebar with a plastic Chippewa County Remonumentation cap in the centerline of east-west gravel road (10 Mile Road), on the extension of a fence line south, 4 feet east of a fence line north. Witnesses:
Corner Fence Post, N06°W 37.35'
Power Pole, N74°W 191.15'
Power Pole, N79°E 165.15'
Large Fence Post, S03°W 48.17'
(Corner falls on top of a north-south culvert which runs under 10 Mile Road).
Note: Unless noted otherwise, distances are to a nail/tag #33142 in the side of the witness object. Bearings are compass bearings corrected for declination.

Signed by Keith R. Waters
Surveyor's Michigan License No. 33142

Date 12-30-96