

SURVEY & REMONUMENTATION

CHIPPEWA COUNTY REMONUMENTATION CORNER

APR 27 1995

LAND CORNER RECORDATION CERTIFICATE

Filing Requirement of Act 74, Mich. P.A. 1970

For corners in **COMMISSION**

<u>Chippewa</u> <small>(County)</small>	Located In:	Corner Code #	
1. Public Land Survey	T <u>46N</u> R <u>1W</u>	<u>B-13</u>	
	T _____ R _____	_____	
	T _____ R _____	_____	
	T _____ R _____	_____	
2. Property Controlling in Section	S _____ T _____ R _____	_____	
	S _____ T _____ R _____	_____	
3. Miscellaneous Property in Sec.	S _____ T _____ R _____	_____	
	S _____ T _____ R _____	_____	
4. Lot No. _____, Recorded Plat _____			
5. Private Claims _____			

\$ 7.00 LAND CORNER
 \$ 2.00 MSSR
 5 DEC 94 12:23 P.M. RECEIPT# 1518
 RECEIVED FOR RECORD
 CHIPPEWA COUNTY - STATE OF MICHIGAN
 SHARON H. KENNEDY, REGISTER OF DEEDS
 Register of Deeds Stamp & File Number


	A	B	C	D	E	F	G	H	I	J	K	L	M
2	6	5	4	3	2	1							
3													
4	7	8	9	10	11	12							
5													
6	18	17	16	15	14	13							
7													
8	19	20	21	22	23	24							
9													
10	30	29	28	27	26	25							
11													
12	31	32	33	34	35	36							
13													

KARR 46N 1W

I, William L. Karr, in a field survey on October 28, 19 94, do hereby certify that under requirements of P.A. 74, Michigan P.A. of 1970, the corner points mentioned in lines 1 and 2 above were in conformance with regulations and rules therefore as required in the current manual of survey instructions of the United States Department of the Interior, Bureau of Land Management or by a decree of a Court of Law and/or that the corner points mentioned in lines 3, 4 and 5 above were in conformance with the rules of the Michigan Board of Land Surveyors or by a Decree of a Court of Law; established, re-established, monumented, re-monumented, recovered, found as expressed below:

NOTE: Not more than 4 corners, all in the same town and range, may be recorded on this certificate.


A. Description of original monument and accessories and/or subsequent restoration:
(B-13) South 1/4 Corner Section 31, T.46 N., R.1 W. (Not common)
1840: Austin Burt set post Cedar 12 N80E 12
Birch 7 N81W 17

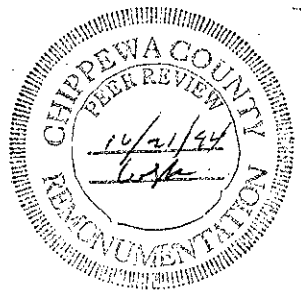

B. Description of corner evidence found and/or method applied in restoring or reestablishing corner:
(B-13) This corner is being re-established as part of the Chippewa County Remonumentation program.
Found no evidence of original corner. Found remains of an old fence line to the North. Re-established corner position on the extension of fence line on the Township line using Standard Corner 31/32 and the Township Corner.

C. Description of monument for corner and accessories established to perpetuate locating the position of the corner:
(B-13) Corner is a 3/4"x 24" iron with aluminum "Chippewa County Remonumentation" cap on extension of fenceline to the South and 25' South of an old 2 track.

Witnesses: 7" Balsam Fir	N23°W	11.62'
4" Maple	S46°W	5.27'
5" Maple	S29°E	15.07'
7" Maple	N27°E	9.25'
North 1/4 Corner Section 6	East	14.63'

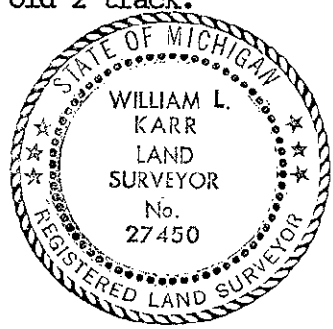

Signed by William L. Karr Date 12/2/94
 Surveyor's Michigan License No. 27450

NOTE: Bearings are compass bearings corrected for declination.
 Distances are to a nail in side of witness objects unless noted.