

SURVEY & REMONUMENTATION

MAR 09 1994

Chippewa County Remonumentation Corner

LAND CORNER RECORDATION CERTIFICATE
Filing Requirement of Act 74, Mich. P.A. 1970

RECEIVED FOR RECORD
 CHIPPEWA COUNTY
 STATE OF MICHIGAN

93 DEC 29 AM 10:24


For corners in **COMMISSION**

Chippewa (County)	Located In:	Corner Code #
1. Public Land Survey	T <u>46N</u> R <u>1W</u>	<u>C-1</u>
	T _____ R _____	_____
	T _____ R _____	_____
	T _____ R _____	_____
2. Property Controlling in Section	S _____ T _____ R _____	_____
	S _____ T _____ R _____	_____
3. Miscellaneous Property in Sec.	S _____ T _____ R _____	_____
	S _____ T _____ R _____	_____

J. Rose Malott
 REGISTER OF DEEDS

Register of Deeds Stamp & File Number

- 4. Lot No. _____, Recorded Plat _____
- 5. Private Claims _____

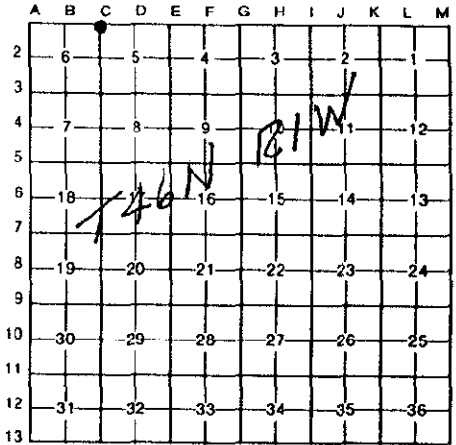

I, William L. Karr, in a field survey on May 24, 19 93 do hereby certify that under requirements of P.A. 74, Michigan P.A. of 1970, the corner points mentioned in lines 1 and 2 above were in conformance with regulations and rules therefore as required in the current manual of survey instructions of the United States Department of the Interior, Bureau of Land Management or by a decree of a Court of Law and/or that the corner points mentioned in lines 3, 4 and 5 above were in conformance with the rules of the Michigan Board of Land Surveyors or by a Decree of a Court of Law; established, re-established, monumented, re-monumented, recovered, found as expressed below:

NOTE: Not more than 4 corners, all in the same town and range, may be recorded on this certificate.

A. Description of original monument and accessories and/or subsequent restoration:
(C-1) Closing Corner of Sections 5 & 6 (T46N-R1W)

1981: William L. Karr, L.S. 27450, recorded in Liber 5, Page 149 of the Chippewa County Corner Records.
 Found 3/4" bar.

Power Pole (E 90)	S70°W	126.59'
Power Pole (E 89)	S36°E	60.67'
Standard Corner (1/2" reroed with cap)	West	23.10'

B. Description of corner evidence found and/or method applied in restoring or reestablishing corner:
(C-1) This corner is being perpetuated as part of the Chippewa County Remonumentation Program.

Found empty monument box 0.8' South of the centerline of Six Mile Road. Reset the corner from three remaining record ties.



C. Description of monument for corner and accessories established to perpetuate locating the position of the corner:
(C-1) Corner is a 3/4" iron in a monument box with plastic "Chippewa County Remonumentation" cap, 0.8' South of the centerline of Six Mile Road.

Witnesses:

Power Pole (E 90)	S70°W	126.59'
Power Pole (E 89)	S36°E	60.67'
4" Twin Elm	N04°W	86.15' (slope)
Top of Guard Rail Post	S02°W	16.21'
Standard Corner 31/32 (1/2" reroed with cap)	East	23.10'



Signed by William L. Karr Date 12/23/93
 Surveyor's Michigan License No. 27450

NOTE: Bearings are compass bearings corrected for declination.
 Distances are to a nail in side of witness objects unless noted.