

**SURVEY & REMONUMENTATION**

MAY 28 1997

**CHIPPEWA COUNTY REMONUMENTATION CORNER**

COMMISSION

**LAND CORNER RECORDATION CERTIFICATE**  
Filing Requirement of Act 74, Mich. P.A. 1970

For corners in

Chippewa (County)	Located In:	Corner Code #
1. Public Land Survey	T46N R 1W	C-3
	T R	
	T R	
	T R	
2. Property Controlling in Section	S T R	
	S T R	
3. Miscellaneous Property in Sec.	S T R	
	S T R	

\$7.00 LAND CORNER


\$2.00 M55R  
2/28/1997 4:19:05 PM Receipt #226  
RECEIVED FOR RECORD  
CHIPPEWA COUNTY - STATE OF MICHIGAN  
SHARON H. KENNEDY, REGISTER OF DEEDS

BOOK 9 PAGE 394  
Register of Deeds Stamp & File Number

4. Lot No. \_\_\_\_\_, Recorded Plat \_\_\_\_\_  
5. Private Claims \_\_\_\_\_

I, Keith R. Waters, in a field survey on 11/12, 1996 do hereby state that under requirements of P.A. 74, Michigan P.A. of 1970, the corner points mentioned in lines 1 and 2 above were in conformance with regulations and rules therefore as required in the current manual of survey instructions of the United States Department of the Interior, Bureau of Land Management or by a decree of a Court of Law and/or that the corner points mentioned in lines 3, 4 and 5 above were in conformance with the rules of the Michigan Board of Land Surveyors or by a Decree of a Court of Law; established, re-established, monumented, recovered, found as expressed below:

NOTE: Not more than 2 corners, all in the same town and range, may be recorded on this certificate.

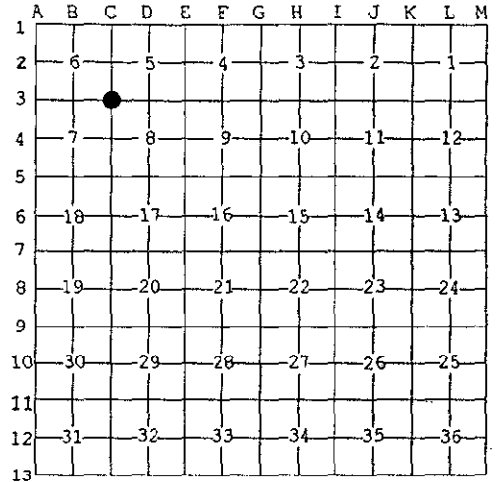

**A. Description of original monument and accessories and/or subsequent restoration:**

C-3 Corner Common to Sections 5, 6, 7, & 8, Town 46 North, Range 1 West

1845 - Original corner (James Mullett) was a 12" Birch.

1905 - County Surveyor Frederick H. Brown notes indicate a large cedar post at original corner location.

Circa 1920's - County Surveyor notes indicate an original U.S. corner. Witnesses: Large Post in Fence, NE 21 feet - Large Gate Post, SE 105 1/2 feet - Pole, SE 101 feet.

1995 - Certificate of Survey, Larry R. Rogers, P.S. 29251, shows corner as a found concrete monument.




**B. Description of corner evidence found and/or method applied in restoring or reestablishing corner:**

This corner is being perpetuated as part of the Chippewa County Remonumentation Program.

Found a 5" diameter concrete monument lying on its side approximately 10 feet from the position as shown on above mentioned

Certificate of Survey. The monument appears to have been disturbed by recent road construction. Re-established the corner position from existing survey control in the area.

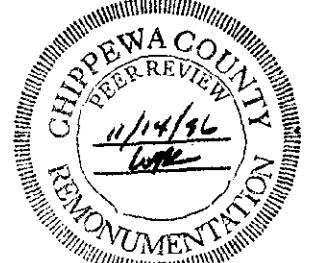

**C. Description of monument for corner and accessories established to perpetuate locating the position of the corner:**

Corner is a 3/4" x 24" rebar with a plastic Chippewa County Remonumentation cap in the approximate centerline of an east-west road (7 Mile Road), about 100 west of the crest of a hill. Witnesses:

10" Cedar, N61°W 64.62'

4" Cedar, S56°W 28.12'

8" Red Pine, S18°E 31.72' (side blaze only)

Power Pole, (DR4-52-35P), N83°E 151.88'

Note: Unless noted otherwise, distances are to a nail/tag #33142 in the side of the witness object. Bearings are compass bearings corrected for declination. Trees are blazed and painted.

Signed by Keith R. Waters  
Surveyor's Michigan License No. 33142

Date 12-30-96  
BOOK 9 PAGE 394