

**SURVEY & REMONUMENTATION**

**CHIPPEWA COUNTY REMONUMENTATION CORNER**

MAY 28 1997

**LAND CORNER RECORDATION CERTIFICATE**  
Filing Requirement of Act 74, Mich. P.A. 1970

For corners in **COMMISSION**

Chippewa (County)	Located In:	Corner Code #
1. Public Land Survey	T <u>46</u> N R <u>1</u> W	<u>C-4</u>
	T ___ R ___	_____
	T ___ R ___	_____
	T ___ R ___	_____
2. Property Controlling in Section	S ___ T ___ R ___	_____
	S ___ T ___ R ___	_____
3. Miscellaneous Property in Sec.	S ___ T ___ R ___	_____
	S ___ T ___ R ___	_____

\$7.00 LAND CORNER

\$2.00 NSSR

2/28/1997 4:19:47 PM Receipt #226  
RECEIVED FOR RECORD  
CHIPPEWA COUNTY - STATE OF MICHIGAN  
SHARON H. KENNEDY, REGISTER OF DEEDS

BOOK **9** PAGE **395**

Register of Deeds Stamp & File Number

4. Lot No. \_\_\_\_\_, Recorded Plat \_\_\_\_\_  
5. Private Claims \_\_\_\_\_

I, Keith R. Waters, in a field survey on 12/16, 1996 do hereby state that under requirements of P.A. 74, Michigan P.A. of 1970, the corner points mentioned in lines 1 and 2 above were in conformance with regulations and rules therefore as required in the current manual of survey instructions of the United States Department of the Interior, Bureau of Land Management or by a decree of a Court of Law and for that the corner points mentioned in lines 3, 4 and 5 above were in conformance with the rules of the Michigan Board of Land Surveyors or by a Decree of a Court of Law, established, re-established, monumented, recovered, found as expressed below:

NOTE: Not more than 2 corners, all in the same town and range, may be recorded on this certificate.

A	B	C	D	E	F	G	H	I	J	K	L	M
1												
2	6		5		4		3		2		1	
3												
4	7		8		9		10		11		12	
5												
6	18		17		16		15		14		13	
7												
8	19		20		21		22		23		24	
9												
10	30		29		28		27		26		25	
11												
12	31		32		33		34		35		36	
13												

**A. Description of original monument and accessories and/or subsequent restoration:**

C-4 1/4 Corner Common to Sections 7 & 8, Town 46 North, Range 1 West


1845 - Original corner (James Mullett) was a 12" White Pine.

1908 - County Surveyor Frederick H. Brown notes indicate that this corner could not be located and that the land was all burned and mostly cleared. His sketch indicates corner midway between section corners 2609 feet north and south.

**B. Description of corner evidence found and/or method applied in restoring or reestablishing corner:**

This corner is being perpetuated as part of the Chippewa County Remonumentation Program.

Found a 1/2" iron bar encased in concrete. 1/2" iron is midway between section corners north and south, the distances to said section corners are within 0.4 feet of above mentioned Frederick H. Brown notes. Accepted corner as found and established witness objects.

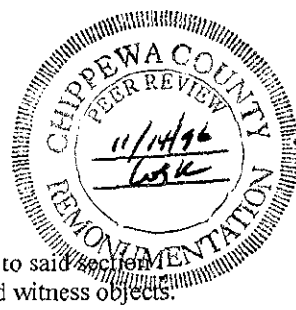

**C. Description of monument for corner and accessories established to perpetuate locating the position of the corner:**

Corner is a 1/2" iron pin encased in concrete. Falls on the westerly extension of 7 1/2 Mile Road, 1/4 mile west of Piche Road

Witnesses:

12" Spruce, N44°E 148.84'

Fence Post, N05°E 35.21' (nail and tag #22428 in side)

Fence Post, S80°W 126.68' (nail and tag #33142 in top)

7" Willow, N81°E 175.66'

Note: Unless noted otherwise, distances are to a nail/tag #33142 in the side of the witness object. Bearings are compass bearings corrected for declination.



Signed by Keith R. Waters  
Surveyor's Michigan License No. 33142

Date 12-30-96

BOOK **9** PAGE **395**