

MAY 28 1997

COMMISSION

CHIPPEWA COUNTY REMONUMENTATION CORNER

LAND CORNER RECORDATION CERTIFICATE
Filing Requirement of Act 74, Mich. P.A. 1970

For corners in

Chippewa

(County)

Located In:

Corner Code #

1. Public Land Survey

T46N R1W

C-5

T R

T R

T R

T R

T R

T R

2. Property Controlling in Section

S

T R

S

T R

3. Miscellaneous Property in Sec.

S

T R

S

T R

\$7.00 LAND CORNER

\$2.00 MSSR

2/28/1997 4:20:40 PM

Receipt #226

RECEIVED FOR RECORD

CHIPPEWA COUNTY - STATE OF MICHIGAN

SHARON H. KENNEDY, REGISTER OF DEEDS

BOOK 9 PAGE 396


Register of Deeds Stamp & File Number

4. Lot No. , Recorded Plat

5. Private Claims

I, Keith R. Waters, in a field survey on 12/04, 1996 do hereby state that under requirements of P.A. 74, Michigan P.A. of 1970, the corner points mentioned in lines 1 and 2 above were in conformance with regulations and rules therefore as required in the current manual of survey instructions of the United States Department of the Interior, Bureau of Land Management or by a decree of a Court of Law and/or that the corner points mentioned in lines 3, 4 and 5 above were in conformance with the rules of the Michigan Board of Land Surveyors or by a Decree of a Court of Law; established, re-established, monumented, recovered, found as expressed below:

NOTE: Not more than 2 corners, all in the same town and range, may be recorded on this certificate.

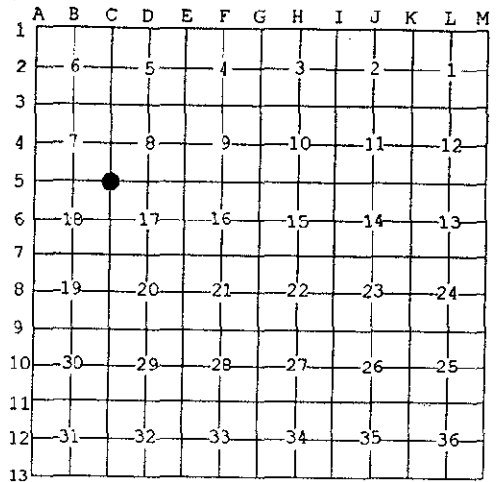

A. Description of original monument and accessories and/or subsequent restoration:

C-5 Corner Common to Sections 7, 8, 17, & 18, Town 46 North, Range 1 West

1845 - Original ties (James Mullett): Fir 8, N57°W 11 links - Fir 10, S40°W 13 links.

1905 - County Surveyor Frederick H. Brown notes indicate "found cross lines but bearing trees are gone and put in by cross lines as they were plain." Set cedar post.

1926 - County Surveyor notes show corner as some broken concrete beside post. Witnesses: Gate Post, NW 29 feet - Elm, East-West Fence lines, North 30 feet and South 30 feet.

B. Description of corner evidence found and/or method applied in restoring or reestablishing corner:

This corner is being perpetuated as part of the Chippewa County Remonumentation Program.

Found a 1" solid iron bar approximately 1 foot south of the centerline of an east-west gravel road on the extension of a fence tree line to the north, 30 feet south of the east-west right-of-way fence on the north side of said road. Found no evidence of the other witnesses mentioned above. Accepted 1" iron bar as best available evidence of corner position.

C. Description of monument for corner and accessories established to perpetuate locating the position of the corner:

Corner is a 1" solid iron bar approximately 1 foot south of the centerline of east-west gravel road (8 Mile Road).

Witnesses:

14" Basswood, S28°E 35.33' (nail and tag #22428 in side)

Power Pole, NORTH 44.47' (nail and tag #22428 in side)

9" Red Maple, N44°W 53.35'

18" White Oak, N63°W 70.75'

Note: Unless noted otherwise, distances are to a nail/tag #33142 in the side of the witness object. Bearings are compass bearings corrected for declination.

Signed by Keith R. Waters

Date 12-30-96

Surveyor's Michigan License No. 33142

BOOK 9 PAGE 396

