

SURVEY & REMONUMENTATION CHIPPEWA COUNTY REMONUMENTATION CORNER

APR 27 1995

LAND CORNER RECORDATION CERTIFICATE
Filing Requirement of Act 74, Mich. P.A. 1970


For corners in
Chippewa **COMMISSION**
(County)

Located In:	Corner Code #
1. Public Land Survey T <u>46N</u> R <u>1W</u>	<u>C-7</u>
T _____ R _____	_____
T _____ R _____	_____
T _____ R _____	_____
2. Property Controlling in Section S _____ T _____ R _____	_____
S _____ T _____ R _____	_____
3. Miscellaneous Property in Sec. S _____ T _____ R _____	_____
S _____ T _____ R _____	_____

\$ 7.00 LAND CORNER
\$ 2.00 MSSR
19 DEC 94 10:16 A.M. RECEIPT# 1769
RECEIVED FOR RECORD
CHIPPEWA COUNTY - STATE OF MICHIGAN
SHARON H. KENNEDY, REGISTER OF DEEDS

Register of Deeds Stamp & File Number

4. Lot No. _____, Recorded Plat _____
5. Private Claims _____

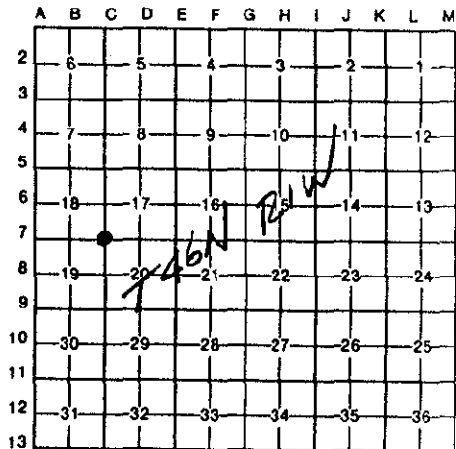

I, William L. Karr, in a field survey on October 19, 19 94, do hereby certify that under requirements of P.A. 74, Michigan P.A. of 1970, the corner points mentioned in lines 1 and 2 above were in conformance with regulations and rules therefore as required in the current manual of survey instructions of the United States Department of the Interior, Bureau of Land Management or by a decree of a Court of Law and/or that the corner points mentioned in lines 3, 4 and 5 above were in conformance with the rules of the Michigan Board of Land Surveyors or by a Decree of a Court of Law; established, re-established, monumented, re-monumented, recovered, found as expressed below:

NOTE: Not more than 4 corners, all in the same town and range, may be recorded on this certificate.

A. Description of original monument and accessories and/or subsequent restoration:
(C-7) Section Corner common to Sections 17, 18, 19 & 20, T.46 N., R.1 W.
1845: J. Mullett set post cor to sec. 17, 18, 19 & 20
Spruce 15 S63E 09 lks Fir 12 N55E 21 lks
1983: W.L. Karr found a monument box buried 7" below road surface and set a railroad spike over the center of the monument box at the road surface. Corner was recorded in L.6 of corners, P.141.
1987: N.E. Hill (MDOT) found the railroad spike as recorded above. He dug out the monument box but found no other survey point and placed a 3/4" pipe w/cap No.27447 in the box. Corner was again recorded in L.7 of corners P.076.

B. Description of corner evidence found and/or method applied in restoring or reestablishing corner:
(C-7) This corner is being perpetuated as part of the Chippewa County Remonumentation program.
Found no evidence of original corner position. Found 3/4" pipe w/cap No.27447 in a monument box, 10.3' South of the centerline of M-28. Accepted corner position as found.



C. Description of monument for corner and accessories established to perpetuate locating the position of the corner:
(C-7) Corner is a 3/4" pipe with plastic cap No. 27447 in a monument box, 10.3' South of the centerline of M-28.

Witnesses: P. Pole (DR4/56M)	N09°E	103.77'
P. Pole (DR4/56)	S20°E	64.96'
MDOT tag in Corner F.Post	S25°W	93.77'
"v" notch in W.end of cmp	N51°W	82.38'
8" W. Pine	S69°W	110.20'



Signed by William L. Karr Date 12/7/94
Surveyor's Michigan License No. 27450 723-12