

**SURVEY &  
REMONUMENTATION**

MAY 28 1997 **CHIPPEWA COUNTY REMONUMENTATION CORNER**

**COMMISSION**

**LAND CORNER RECORDATION CERTIFICATE**  
Filing Requirement of Act 74, Mich. P.A. 1970

For corners in

Chippewa \_\_\_\_\_ Located In: \_\_\_\_\_ Corner Code # \_\_\_\_\_  
(County)


1. Public Land Survey T46N R 1W C-8  
T \_\_\_\_\_ R \_\_\_\_\_  
T \_\_\_\_\_ R \_\_\_\_\_  
T \_\_\_\_\_ R \_\_\_\_\_

2. Property Controlling S \_\_\_\_\_ T \_\_\_\_\_ R \_\_\_\_\_  
in Section S \_\_\_\_\_ T \_\_\_\_\_ R \_\_\_\_\_

3. Miscellaneous S \_\_\_\_\_ T \_\_\_\_\_ R \_\_\_\_\_  
Property in Sec. S \_\_\_\_\_ T \_\_\_\_\_ R \_\_\_\_\_

4. Lot No. \_\_\_\_\_, Recorded Plat \_\_\_\_\_

5. Private Claims \_\_\_\_\_

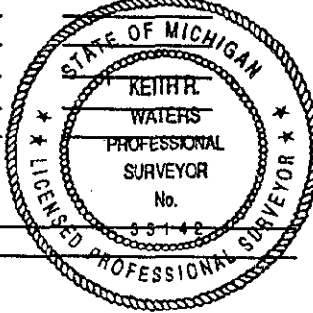

\$7.00 LAND CORNER

\$2.00 MSSR  
2/28/1997 4:22:24 PM Receipt #226  
RECEIVED FOR RECORD  
CHIPPEWA COUNTY - STATE OF MICHIGAN  
SHARON H. KENNEDY, REGISTER OF DEEDS

BOOK 9 PAGE 398  
Register of Deeds Stamp & File Number

	A	B	C	D	E	F	G	H	I	J	K	L	M
1													
2	6		5		4		3		2		1		
3													
4	7		8		9		10		11		12		
5													
6	18		17		16		15		14		13		
7													
8	19		20		21		22		23		24		
9													
10	30		29		28		27		26		25		
11													
12	31		32		33		34		35		36		
13													

I, Keith R. Waters, in a field survey on 11/11, 1996 do hereby state that under requirements of P.A. 74, Michigan P.A. of 1970, the corner points mentioned in lines 1 and 2 above were in conformance with regulations and rules therefore as required in the current manual of survey instructions of the United States Department of the Interior, Bureau of Land Management or by a decree of a Court of Law and /or that the corner points mentioned in lines 3, 4 and 5 above were in conformance with the rules of the Michigan Board of Land Surveyors or by a Decree of a Court of Law; established, re-established, monumented, recovered, found as expressed below:


NOTE: Not more than 2 corners, all in the same town and range, may be recorded on this certificate.

**A. Description of original monument and accessories and/or subsequent restoration:**

- C-8 1/4 Corner Common to Sections 19 & 20, Town 46 North, Range 1 West
- 1845 - Original corner (James Mullett) was a 10" Fir.
- 1905 - County Surveyor Frederick H. Brown notes indicate "could not find any corner, lumbered and burnt over." His sketch shows corner mid-way between section corners 2665 feet north and south.
- 1912 - County Surveyor Frederick H. Brown notes show same information as 1905 notes.

**B. Description of corner evidence found and/or method applied in restoring or reestablishing corner:**

This corner is being re-established as part of the Chippewa County Remonumentation Program. Found no evidence of corner. Re-established corner by single proportionate measurement on line between section corners 2659.4 feet north and 2659.4 feet south. Corner position falls 31 feet west of an old large corner fence post on the east side of north-south gravel road (Big Pine Road), and is also 31 feet off of the remains of an old right-of-way fence on the west side of said road.

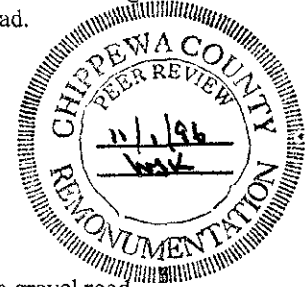

**C. Description of monument for corner and accessories established to perpetuate locating the position of the corner:**

- Corner is a 3/4" x 24" rebar with a plastic Chippewa County Remonumentation cap in the centerline of a north-south gravel road. (Big Pine Road). Witnesses:
- 9" Spruce, S75°W 27.66'
- 5" Spruce, N21°W 75.91'
- Power Pole, N15°E 138.00'
- Power Pole, (DR4-57-8), S06°E 248.21'

Note: Distances are to a nail/tag #33142 in the side of the witness object. Bearings are compass bearings corrected for declination. Trees are blazed and painted.

Signed by Keith R. Waters Date 12-30-96  
Surveyor's Michigan License No. 33142

BOOK 9 PAGE 398