

**SURVEY &  
REMONUMENTATION**

MAR 09 1994

Chippewa County Remonumentation Corner

RECEIVED FOR RECORD  
CHIPPEWA COUNTY  
STATE OF MICHIGAN

**LAND CORNER RECORDATION CERTIFICATE**  
Filing Requirement of Act 74, Mich. P.A. 1970

93 DEC 29 AM 10:26

**COMMISSION**

For corners in

Chippewa  
(County)

Located In:


Corner Code ##

- |                                       |                          |            |
|---------------------------------------|--------------------------|------------|
| 1. Public Land Survey                 | T <u>46N</u> R <u>1W</u> | <u>C-9</u> |
|                                       | T _____ R _____          | _____      |
|                                       | T _____ R _____          | _____      |
|                                       | T _____ R _____          | _____      |
| 2. Property Controlling<br>in Section | S _____ T _____ R _____  | _____      |
|                                       | S _____ T _____ R _____  | _____      |
| 3. Miscellaneous<br>Property in Sec.  | S _____ T _____ R _____  | _____      |
|                                       | S _____ T _____ R _____  | _____      |
| 4. Lot No. _____, Recorded Plat _____ |                          |            |
| 5. Private Claims _____               |                          |            |

*J. Roger Malott*  
REGISTER OF DEEDS

Register of Deeds Stamp & File Number

I, William L. Karr, in a field survey on December 6, 19 93, do hereby certify that under requirements of P.A. 74, Michigan P.A. of 1970, the corner points mentioned in lines 1 and 2 above were in conformance with regulations and rules therefore as required in the current manual of survey instructions of the United States Department of the Interior, Bureau of Land Management or by a decree of a Court of Law and/or that the corner points mentioned in lines 3, 4 and 5 above were in conformance with the rules of the Michigan Board of Land Surveyors or by a Decree of a Court of Law; established, re-established, monumented, re-monumented, recovered, found as expressed below:

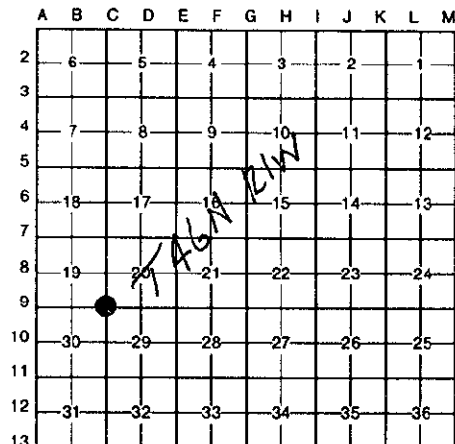


**NOTE: Not more than 4 corners, all in the same town and range, may be recorded on this certificate.**

A. Description of original monument and accessories and/or subsequent restoration:

(C-9) Section Corner Common to Sections 19, 20, 29 & 30, (T46N-R1W)

1991 William L. Karr, L.S. 27450 recorded in Liber 7, Page 384 of the Chippewa County Corner Records. Set 1/2" iron with L.S. cap #27450.  
 Sawed Off Telephone Pole N38°W 66.70'  
 Northeast Edge of Stop Sign N23°W 41.53'  
 Power Pole DR4/57/14 N24°E 79.10'  
 Southwest Edge of Stop Sign S16°E 52.10'

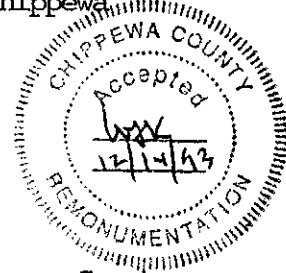

B. Description of corner evidence found and/or method applied in restoring or reestablishing corner:

(C-9) This corner is being perpetuated as part of the Chippewa County Remonumentation Program.

Found 1/2" iron with L.S. cap #27450 in paved road intersection. Found four recorded witness objects. Lowered corner prior to road reconstruction. Recovered corner after construction completed. Added two additional witnesses.

C. Description of monument for corner and accessories established to perpetuate locating the position of the corner:

(C-9) Corner is a 1/2" x 24" iron with P.S. cap #27450, 8" below gravel surface. Corner falls 2' South of centerline of 10 Mile Road, 3' West of centerline of gravel road to the North and 2' West of centerline of gravel road to the South.

Witnesses:

Sawed Off Telephone Pole	N38°W	66.72' (existing nail & L.S. tag)
Northeast Edge of Stop Sign Post	N23°W	41.53' (existing)
Power Pole DR4/57/14	N24°E	79.08' (existing nail & L.S. tag)
Southwest Edge of Stop Sign Post	S16°E	52.08' (existing)
"V" in West End of 18" C.M.P.	S20°W	48.20'
Large Corner Fence Post	S26°W	60.04'

Signed by William L. Karr Date 12/14/93

Surveyor's Michigan License No. 27450



NOTE: Bearings are compass bearings corrected for declination.  
Distances are to a nail in side of witness objects unless noted.