

MAY 28 1997

COMMISSION

CHIPPEWA COUNTY REMONUMENTATION CORNER

LAND CORNER RECORDATION CERTIFICATE
Filing Requirement of Act 74, Mich. P.A. 1970

For corners in

Chippewa _____ Located In: _____ Corner Code # _____
(County)

- 1. Public Land Survey T46N R 1W C-10
T _____ R _____
T _____ R _____
T _____ R _____
- 2. Property Controlling S _____ T _____ R _____
in Section S _____ T _____ R _____
- 3. Miscellaneous S _____ T _____ R _____
Property in Sec. S _____ T _____ R _____



- 4. Lot No. _____, Recorded Plat _____
- 5. Private Claims _____

\$7.00 LAND CORNER

\$2.00 MSSR

2/28/1997 4:23:18 PM Receipt #226
RECEIVED FOR RECORD
CHIPPEWA COUNTY - STATE OF MICHIGAN
SHARON H. KENNEDY, REGISTER OF DEEDS

BOOK 9 PAGE 399

Register of Deeds Stamp & File Number

I, Keith R. Waters, in a field survey on 08/09, 1996 do hereby state that under requirements of P.A. 74, Michigan P.A. of 1970, the corner points mentioned in lines 1 and 2 above were in conformance with regulations and rules therefore as required in the current manual of survey instructions of the United States Department of the Interior, Bureau of Land Management or by a decree of a Court of Law and /or that the corner points mentioned in lines 3, 4 and 5 above were in conformance with the rules of the Michigan Board of Land Surveyors or by a Decree of a Court of Law; established, re-established, monumented, recovered, found as expressed below:

NOTE: Not more than 2 corners, all in the same town and range, may be recorded on this certificate.

	A	B	C	D	E	F	G	H	I	J	K	L	M
1													
2	6		5		4		3		2		1		
3													
4	7		8		9		10		11		12		
5													
6	18		17		16		15		14		13		
7													
8	19		20		21		22		23		24		
9													
10	30		29		28		27		26		25		
11													
12	31		32		33		34		35		36		
13													

A. Description of original monument and accessories and/or subsequent restoration:

- C-10 1/4 Corner Common to Sections 29 & 30, Town 46 North, Range 1 West
- 1845 - Original corner (James Mullett) was an 8" Birch.
- 1891 - County Surveyor Frederick H. Brown notes in Section 30 show this as an original corner, with a distance of 2635 feet to the original section corner to the south.
- 1907 - County Surveyor Frederick H. Brown notes in Section 29 show this as an original corner, with a distances of 2625 feet to the section corner to the south and 2460 feet to the section corner to the north. An overall distance between said section corners is shown as 5085 feet.


B. Description of corner evidence found and/or method applied in restoring or reestablishing corner:

This corner is being re-established as part of the Chippewa County Remonumentation Program. Found no evidence of corner. The distance between recovered section corners C-9 to the north and C-11 to the south is 5084.65 feet, compared to 5085 feet as shown in above mentioned Brown notes. The distance from section corner C-9 south to north 1/16 line fences in both Sections 29 and 30 is 1229.7 feet, compared to Brown's distance of 1230 feet. Re-established corner on line between section corners north and south at a pro-rated distance according to County Surveyor notes (2459.83 feet north and 2624.82 feet south). Corner falls in the centerline of a north-south seasonal road, approximately 15 feet north of fence lines east and west. Based on other evidence, I do not believe that these fences were built based on the original corner location.

C. Description of monument for corner and accessories established to perpetuate locating the position of the corner:

- Corner is a 1/4" x 24" rebar with a plastic Chippewa County Remonumentation cap in the centerline of a north-south seasonal dirt road, approximately 15 feet north and the extension of fence lines east and west. Witnesses:
- 1/2" Iron with cap #33142, EAST 30.00'
- 1/2" Iron with cap #33142, WEST 30.00'
- Corner Fence Post, S69°W 32.88'
- Fence Post, N55°W 33.31'

Note: Unless noted otherwise, distances are to a nail/tag #33142 in the side of the witness object. Bearings are compass bearings corrected for declination.

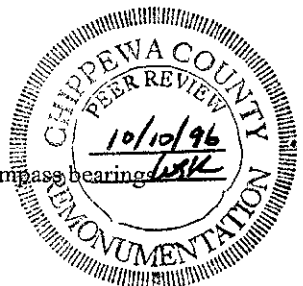

Signed by Keith R. Waters
Surveyor's Michigan License No. 33142

Date 12-30-96

BOOK 9 PAGE 399