

MAY 28 1997 **CHIPPEWA COUNTY REMONUMENTATION CORNER**

COMMISSION

LAND CORNER RECORDATION CERTIFICATE
Filing Requirement of Act 74, Mich. P.A. 1970

For corners in

Chippewa (County)	Located in:	Corner Code #
1. Public Land Survey	T46N R1W	C-11
	T___ R___	_____
	T___ R___	_____
	T___ R___	_____
2. Property Controlling in Section	S___ T___ R___	_____
	S___ T___ R___	_____
3. Miscellaneous Property in Sec.	S___ T___ R___	_____
	S___ T___ R___	_____

\$7.00 LAND CORNER

\$2.00 NSSR
2/28/1997 4:24:38 PM Receipt #226
RECEIVED FOR RECORD
CHIPPEWA COUNTY - STATE OF MICHIGAN
SHARON H. KENNEDY, REGISTER OF DEEDS

BOOK 9 PAGE 400

Register of Deeds Stamp & File Number

4. Lot No. _____, Recorded Plat _____
5. Private Claims _____

I, Keith R. Waters, in a field survey on 08/09, 1996 do hereby state that under requirements of P.A. 74, Michigan P.A. of 1970, the corner points mentioned in lines 1 and 2 above were in conformance with regulations and rules therefore as required in the current manual of survey instructions of the United States Department of the Interior, Bureau of Land Management or by a decree of a Court of Law and for that the corner points mentioned in lines 3, 4 and 5 above were in conformance with the rules of the Michigan Board of Land Surveyors or by a Decree of a Court of Law; established, re-established, monumented, recovered, found as expressed below:

NOTE: Not more than 2 corners, all in the same town and range, may be recorded on this certificate.

A	B	C	D	E	F	G	H	I	J	K	L	M
1												
2	6	5			4		3		2		1	
3												
4	7	8			9		10		11		12	
5												
6	13	17			16		15		14		13	
7												
8	19	20			21		22		23		24	
9												
10	30	29			28		27		26		25	
11												
12	31	32			33		34		35		36	
13												

A. Description of original monument and accessories and/or subsequent restoration:

C-11 Corner Common to Sections 29, 30, 31, & 32, Town 46 North, Range 1 West
1845 - Original ties (James Mullett): Sugar 12, S78°E 18 links - Birch 24, N23°W 12 links.
1891, 1899, 1905, 1907 - County Surveyor Frederick H. Brown notes indicate an original corner, stone and stake.
Circa 1920's - County Surveyor notes show corner with various witnesses, including a 6" maple northeast 73 feet.




B. Description of corner evidence found and/or method applied in restoring or reestablishing corner:

This corner is being perpetuated as part of the Chippewa County Remonumentation Program.
Found an old 4" diameter concrete monument with a rounded top in the intersection of gravel roads north, south, east, and west, 7 inches below the gravel surface. Also found a large half dead maple 73 feet to the northeast per old County Surveyor notes.
Distances to section corners east, west, and north also check very well with above mentioned Brown notes.
Placed a 1/2" x 18" rebar on the north side of monument to assist in location. Accepted corner as found and established witness objects.

C. Description of monument for corner and accessories established to perpetuate locating the position of the corner:

Corner is a 4" diameter concrete monument with a rounded top approximately 4 feet north of the centerline of east-west gravel road (11 Mile Road), at the intersection of a gravel road south and a 2 track road to the north. Witnesses:
20" Sugar Maple, N21°E 67.38'
12" Sugar Maple, N35°W 58.60'
Power Pole (DR4-39A-14), N47°E
28" Sugar Maple, S47°E 54.78' (small side blaze only)
(Set a 1/2" iron on the north side of monument to assist in location).
Note: Unless noted otherwise, distances are to a nail/tag #33142 in the side of the witness object. Bearings are compass bearings corrected for declination. Trees are blazed and painted.

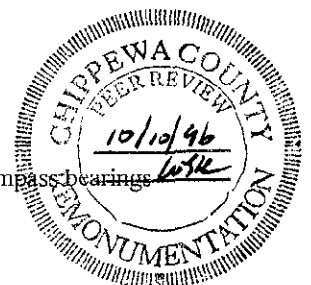

Signed by Keith R. Waters
Surveyor's Michigan License No. 33142

Date 12-30-96