

CHIPPEWA COUNTY REMONUMENTATION CORNER


MAY 28 1997

LAND CORNER RECORDATION CERTIFICATE \$7.00 RECORDING FEE
Filing Requirement of Act 74, Mich. P.A. 1970

For corners in
Chippewa
(County)

Located In: Corner Code #

- 1. Public Land Survey T46N R 1W C-12
T R
T R
T R
- 2. Property Controlling in Section S T R
S T R
- 3. Miscellaneous Property in Sec. S T R
S T R

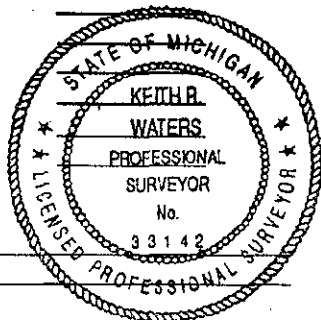

\$2.00 MSSR

3/3/1997 4:59:21 PM Receipt #275
RECEIVED FOR RECORD
CHIPPEWA COUNTY - STATE OF MICHIGAN
SHARON H. KENNEDY, REGISTER OF DEEDS

BOOK 10 PAGE 1

Register of Deeds Stamp & File Number

- 4. Lot No. _____, Recorded Plat _____
- 5. Private Claims _____

	A	B	C	D	E	F	G	H	I	J	K	L	M
1													
2	6		5		4		3		2		1		
3													
4	7		8		9		10		11		12		
5													
6	18		17		16		15		14		13		
7													
8	19		20		21		22		23		24		
9													
10	30		29		28		27		26		25		
11													
12	31		32		33		34		35		36		
13													

I, Keith R. Waters, in a field survey on 08/09, 1996 do hereby state that under requirements of P.A. 74, Michigan P.A. of 1970, the corner points mentioned in lines 1 and 2 above were in conformance with regulations and rules therefore as required in the current manual of survey instructions of the United States Department of the Interior, Bureau of Land Management or by a decree of a Court of Law and /or that the corner points mentioned in lines 3, 4 and 5 above were in conformance with the rules of the Michigan Board of Land Surveyors or by a Decree of a Court of Law; established, re-established, monumented, recovered, found as expressed below:


NOTE: Not more than 2 corners, all in the same town and range, may be recorded on this certificate.

A. Description of original monument and accessories and/or subsequent restoration:

C-12 1/4 Corner Common to Sections 31 & 32, Town 46 North, Range 1 West
1845 - Original ties (James Mullett): Spruce 12, S29°E 24 links - Fir 12, S30°W 13 links.
1889, 1905 - Surveyor Frederick H. Brown notes indicate "the 1/4 post was in burning and could not be located."
His drawings of Sections 31 and 32 show distances of 5330, 5268, and 5253 feet between original section corners north and south. He notes the discrepancy between these distances and states that he does not know which is correct.

B. Description of corner evidence found and/or method applied in restoring or reestablishing corner:

This corner is being re-established as part of the Chippewa County Remonumentation Program.
Found no evidence of corner. Re-established corner by single proportionate measurement between section corners 2638.10 feet north and 2638.10 feet south. Corner falls approximately 13 feet south of a fence line to the east. Based on above mentioned Frederick H. Brown notes I don't believe that the fence was erected from an original corner location.

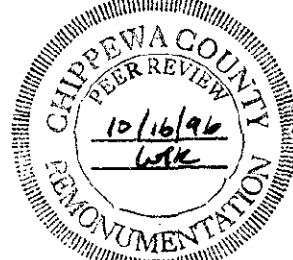

C. Description of monument for corner and accessories established to perpetuate locating the position of the corner:

Corner is a 3/4" x 24" rebar with a plastic Chippewa County Remonumentation cap west of the centerline of north-south gravel road, 13 feet south of the extension of a fence line to the east. Witnesses:
Power Pole, N08°W 376.10'
Power Pole, N86°W 92.17'
Wood Post, N46°W 35.76'
5" Spruce, S89°E 127.14'

Note: Unless noted otherwise, distances are to a nail/tag #33142 in the side of the witness object. Bearings are compass bearings corrected for declination. Trees are blazed and painted.

Signed by Keith R. Waters
Surveyor's Michigan License No. 33142

Date 12-30-96

BOOK 10 PAGE 1