

MAR 09 1994

COMMISSION

Chippewa County Remonumentation Corner

RECEIVED FOR RECORD
CHIPPEWA COUNTY
STATE OF MICHIGAN

LAND CORNER RECORDATION CERTIFICATE 93 DEC 29 AM 10:24
Filing Requirement of Act 74, Mich. P.A. 1970

J. Roger Malotte
REGISTER OF DEEDS


For corners in
Chippewa
(County)

Located In:	Corner Code #
T <u>46N</u> R <u>1W</u>	<u>D-1</u>
T _____ R _____	_____
T _____ R _____	_____
T _____ R _____	_____
T _____ R _____	_____
S _____ T _____ R _____	_____
S _____ T _____ R _____	_____
S _____ T _____ R _____	_____
S _____ T _____ R _____	_____

Register of Deeds Stamp & File Number

4. Lot No. _____, Recorded Plat _____
5. Private Claims _____

I, William L. Karr, in a field survey on December 15, 19 93, do hereby certify that under requirements of P.A. 74, Michigan P.A. of 1970, the corner points mentioned in lines 1 and 2 above were in conformance with regulations and rules therefore as required in the current manual of survey instructions of the United States Department of the Interior, Bureau of Land Management or by a decree of a Court of Law and/or that the corner points mentioned in lines 3, 4 and 5 above were in conformance with the rules of the Michigan Board of Land Surveyors or by a Decree of a Court of Law; established, re-established, monumented, re-monumented, recovered, found as expressed below:

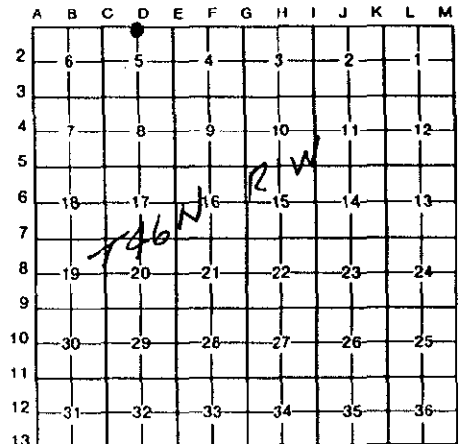

NOTE: Not more than 4 corners, all in the same town and range, may be recorded on this certificate.

A. Description of original monument and accessories and/or subsequent restoration:
(D-1) North 1/4 Corner of Section 5 (T46N-R1W)

Corner not set in original survey.


B. Description of corner evidence found and/or method applied in restoring or reestablishing corner:
(D-1) This corner is being established as part of the Chippewa County Remonumentation Program.

Established corner position on line between the South 1/4 and Southwest corners of Section 32 and on the extension of a fence line to the South.

C. Description of monument for corner and accessories established to perpetuate locating the position of the corner:
(D-1) Corner is a 3/4" x 24" iron with plastic "Chippewa County Remonumentation" cap. Corner falls 2.0' North of the centerline of Six Mile Road.

Witnesses:

1/2" Iron I.S. 28424	N27°E	56.59'
South 1/4 Corner Section 32	East	27.05'
Power Pole (E-76A)	S68°E	155.64'
Power Pole (E-77)	S03°E	49.12'
4" Scotch Pine	N06°W	45.41'

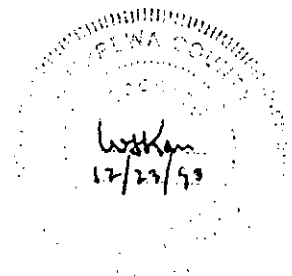

Signed by William L. Karr Date 12/23/93

Surveyor's Michigan License No. 27450

NOTE: Bearings are compass bearings corrected for declination.
Distances are to a nail in side of witness objects unless noted.