

SURVEY & REMONUMENTATION

MAY 28 1997

CHIPPEWA COUNTY REMONUMENTATION CORNER

COMMISSION


LAND CORNER RECORDATION CERTIFICATE

Filing Requirement of Act 74, Mich. P.A. 1970

For corners in

Chippewa Located In: Corner Code #
(County)

- 1. Public Land Survey T46N R 1W D-5
T R
T R
T R
- 2. Property Controlling S T R
in Section S T R
- 3. Miscellaneous S T R
Property in Sec. S T R

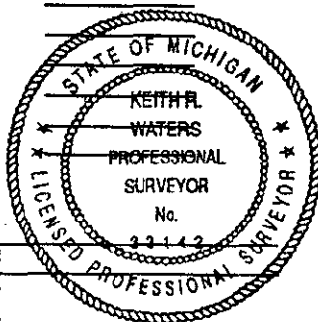

\$7.00 RECORDING FEE

\$2.00 MSSR

3/3/1997 5:00:41 PM Receipt #275
RECEIVED FOR RECORD
CHIPPEWA COUNTY - STATE OF MICHIGAN
SHARON H. KENNEDY, REGISTER OF DEEDS

BOOK 10 PAGE 3

Register of Deeds Stamp & File Number

- 4. Lot No. _____, Recorded Plat _____
- 5. Private Claims _____

I, Keith R. Waters, in a field survey on 10/31, 1996 do hereby state that under requirements of P.A. 74, Michigan P.A. of 1970, the corner points mentioned in lines 1 and 2 above were in conformance with regulations and rules therefore as required in the current manual of survey instructions of the United States Department of the Interior, Bureau of Land Management or by a decree of a Court of Law and /or that the corner points mentioned in lines 3, 4 and 5 above were in conformance with the rules of the Michigan Board of Land Surveyors or by a Decree of a Court of Law; established, re-established, monumented, recovered, found as expressed below:

NOTE: Not more than 2 corners, all in the same town and range, may be recorded on this certificate.

1	A	B	C	D	E	F	G	H	I	J	K	L	M
2	6		5		4		3		2		1		
3													
4	7		8		9		10		11		12		
5													
6	18		17		16		15		14		13		
7													
8	19		20		21		22		23		24		
9													
10	30		29		28		27		26		25		
11													
12	31		32		33		34		35		36		
13													

A. Description of original monument and accessories and/or subsequent restoration:

D-5 1/4 Corner Common to Sections 8 & 17, Town 46 North, Range 1 West

1845 - Original ties (James Mullett): Spruce 12, N74°E 16 links - Birch 15, S74°W 09 links.

1908 - County Surveyor Frederick H. Brown notes indicate that "the bearing tree had been grubbed out and lay beside the road and I think I located the place it occupied and put in corner." His sketch shows distances of 2629 feet to the section corner east and 2632 feet to the section corner west.

1992 - Certificate of Survey, liber 605, page 692, Chippewa County records, shows a 1/2" rod at this corner position. Witnesses: Fence Corner, N03°W 25.61' - Fence Post, N45°W 36.56' - Fence Post, N43°E 33.55' - Fence Post, South 34.45'.


B. Description of corner evidence found and/or method applied in restoring or reestablishing corner:

This corner is being perpetuated as part of the Chippewa County Remonumentation Program.

Found a bent 1/2" rebar at the surface of an east-west seasonal road (8 Mile Road) on the extension of a fence line to the north.

Also found three of the witness objects as shown in above mentioned Certificate of Survey. Found rebar is 2626.96 feet from the section corner to the east, 2622.66 feet from the section corner to the west, and is 3.7 feet south of a straight line between said section corners.

Accepted corner position as found and replaced the bent rebar with a 3/4" x 24" rebar and plastic Chippewa County Remonumentation

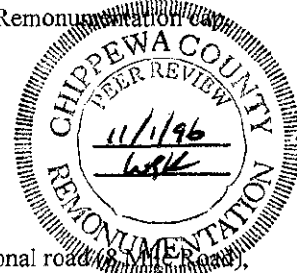

C. Description of monument for corner and accessories established to perpetuate locating the position of the corner:

Corner is a 3/4" x 24" rebar with a plastic Chippewa County Remonumentation in the centerline of an east-west seasonal road on the extension of a fence line to the north. Witnesses:

Corner Fence Post, N03°W 25.61' (nail and tag #22428 in side)

Fence Post, N45°W 36.56' (nail and tag #22428 in side)

Fence Post, N43°E 33.55' (nail and tag #22428 in side)

4" Aspen, S80°W 111.95'

Note: Unless noted otherwise, distances are to a nail/tag #33142 in the side of the witness object. Bearings are compass bearings corrected for declination. Trees are blazed and painted.

Signed by Keith R. Waters
Surveyor's Michigan License No. 33142

Date 12-30-1996 BOOK 10 PAGE 3

BOOK 10 PAGE 3