

**SURVEY & REMONUMENTATION**

CHIPPEWA COUNTY REMONUMENTATION CORNER

APR 27 1995

**LAND CORNER RECORDATION CERTIFICATE**

Filing Requirement of Act 74, Mich. P.A. 1970


For corners in **COMMISSION**

<u>Chippewa</u> (County)	Located In:	Corner Code #
1. Public Land Survey	T <u>46N</u> R <u>1W</u>	<u>D-7</u>
	T _____ R _____	_____
	T _____ R _____	_____
	T _____ R _____	_____
2. Property Controlling in Section	S _____ T _____ R _____	_____
	S _____ T _____ R _____	_____
3. Miscellaneous Property in Sec.	S _____ T _____ R _____	_____
	S _____ T _____ R _____	_____
4. Lot No. _____, Recorded Plat _____		
5. Private Claims _____		

\$ 7.00 LAND CORNER  
 \$ 2.00 HSSR  
 19 DEC 94 10:16 A.M. RECEIPT# 1769  
 RECEIVED FOR RECORD  
 CHIPPEWA COUNTY - STATE OF MICHIGAN  
 SHARON H. KENNEDY, REGISTER OF DEEDS  
 Register of Deeds Stamp & File Number

I, William L. Karr, in a field survey on October 19, 1994, do hereby certify that under requirements of P.A. 74, Michigan P.A. of 1970, the corner points mentioned in lines 1 and 2 above were in conformance with regulations and rules therefore as required in the current manual of survey instructions of the United States Department of the Interior, Bureau of Land Management or by a decree of a Court of Law and/or that the corner points mentioned in lines 3, 4 and 5 above were in conformance with the rules of the Michigan Board of Land Surveyors or by a Decree of a Court of Law; established, re-established, monumented, re-monumented, recovered, found as expressed below:

**NOTE: Not more than 4 corners, all in the same town and range, may be recorded on this certificate.**

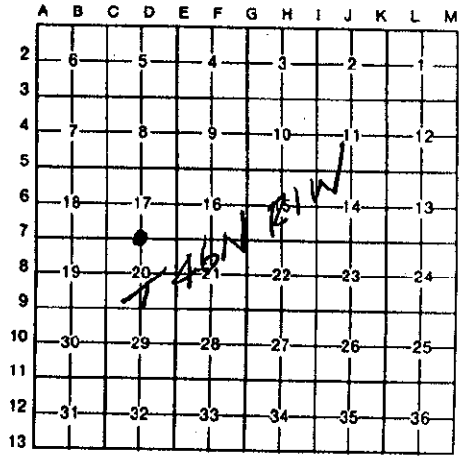

A. Description of original monument and accessories and/or subsequent restoration:

- (D-7) 1/4 Corner Sections 17 & 20, T.46 N., R.1 W.
- 1845: J. Mullett set quarter section post. Fir 6 S40W 07 lks  
Fir 6 N25W 19 lks
- 1905: County Surveyor notes show a distance of 5246' for the total mile (5225.68' today). GLO is 5263.50'.
- 1905: County Surveyor notes show 2603' for the East 1/2 mile and 2627' for the West 1/2 mile (5230' total).
- 1987: MDOI shows 5225.72' for the mile (no breakdown).
- 1994: L.R. Rogers set a 1/2" iron w/cap No. 29251 on extension of fencelines to North and South.

B. Description of corner evidence found and/or method applied in restoring or reestablishing corner:

(D-7) This corner is being perpetuated as part of the Chippewa County Remonumentation program.

Found no evidence of original corner. Found a 1/2" pin w/cap No. 29251, 4.0' South of the centerline of M-28 as noted above. Distance West to Section corner is 2625.16'. Distance East to Section corner is 2600.52'. Corner falls 0.80' South of a straight line between the Section corners. Accepted corner position as found.



C. Description of monument for corner and accessories established to perpetuate locating the position of the corner:

(D-7) Corner is a 1/2" iron with cap No. 29251, 4.0' South of the centerline of M-28 and on the extension of fencelines to the North and South.

Witnesses: P. Pole  
 S.W. corner of W.end conc. H.wall N09°E 61.95'  
 P. Pole(DR4/48) S51°E 42.72'  
 15" W. Pine S50°W 89.15'  
 N53°W 94.42'



Signed by William L. Karr Date 12/7/94

Surveyor's Michigan License No. 27450

723-12

NOTE: Bearings are compass bearings corrected for declination.  
 Distances are to a nail in side of witness objects unless noted.