

SURVEY & REMONUMENTATION

MAR 09 1994

COMMISSION

For corners in

Chippewa
(County)

Located In:

Corner Code #

- 1. Public Land Survey T 46N R 1W
- T _____ R _____
- T _____ R _____
- T _____ R _____
- 2. Property Controlling S _____ T _____ R _____
- in Section S _____ T _____ R _____
- 3. Miscellaneous S _____ T _____ R _____
- Property in Sec. S _____ T _____ R _____

D-9

RECEIVED FOR RECORD
CHIPPEWA COUNTY
STATE OF MICHIGAN


DEC 29 AM 10:26

LAND CORNER RECORDATION CERTIFICATE
Filing Requirement of Act 74, Mich. P.A. 1970

J. Roger Malott
REGISTER OF DEEDS

Register of Deeds Stamp & File Number

- 4. Lot No. _____, Recorded Plat _____
- 5. Private Claims _____

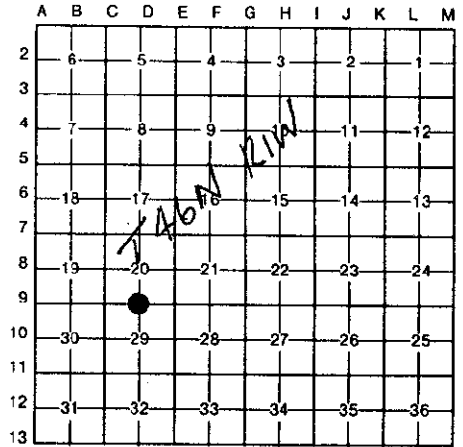

I, William L. Karr, in a field survey on December 6, 1993 do hereby certify that under requirements of P.A. 74, Michigan P.A. of 1970, the corner points mentioned in lines 1 and 2 above were in conformance with regulations and rules therefore as required in the current manual of survey instructions of the United States Department of the Interior, Bureau of Land Management or by a decree of a Court of Law and/or that the corner points mentioned in lines 3, 4 and 5 above were in conformance with the rules of the Michigan Board of Land Surveyors or by a Decree of a Court of Law; established, re-established, monumented, re-monumented, recovered, found as expressed below:

NOTE: Not more than 4 corners, all in the same town and range, may be recorded on this certificate.

A. Description of original monument and accessories and/or subsequent restoration:

(D-9) 1/4 Corner Common to Sections 20 & 29, (T46N-R1W)

1985 William L. Karr, L.S. 27450 recorded in Liber 6, Page 374 of the Chippewa County Corner Records, set a 1/2" iron with L.S. cap #27450.

Corner Fence Post	North	98.65'
Notch in C.M.P.	S40°E	52.25'
Corner Fence Post	South	48.87'
Fence Post	S38°W	61.91'



B. Description of corner evidence found and/or method applied in restoring or reestablishing corner:

(D-9) This corner is being perpetuated as part of the Chippewa County Remonumentation Program.

Found a bent 1/2" iron and three remaining record witness objects to the South. Reset iron from previous survey control. Matched record ties well. Added one additional witness.

C. Description of monument for corner and accessories established to perpetuate locating the position of the corner:

(D-9) Corner is a 1/2" x 24" iron with P.S. tag #27450, 8" below gravel surface of 10 Mile Road. Corner falls on centerline of 10 Mile Road and on extension of fences to the North and South.

Witnesses:

Fence Post	S38°W	61.84'	(existing Pk nail)
Corner Fence Post	South	48.99'	(existing Pk nail)
"V" Notch in West End of 24" C.M.P.	S13°E	39.73'	
"V" Notch in East End of 24" C.M.P.	S40°E	52.26'	(existing)

Signed by William L. Karr

Date 12/15/93

Surveyor's Michigan License No. 27450



NOTE: Bearings are compass bearings corrected for declination. Distances are to a nail in side of witness objects unless noted.