

SURVEY & REMONUMENTATION

MAY 28 1997


CHIPPEWA COUNTY REMONUMENTATION CORNER

LAND CORNER RECORDATION CERTIFICATE
Filing Requirement of Act 74, Mich. P.A. 1970

For corners in
COMMISSION

Chippewa Located In: Corner Code #
(County)

- 1. Public Land Survey T46N R 1W D-11
T R
T R
T R
- 2. Property Controlling in Section S T R
S T R
- 3. Miscellaneous Property in Sec. S T R
S T R

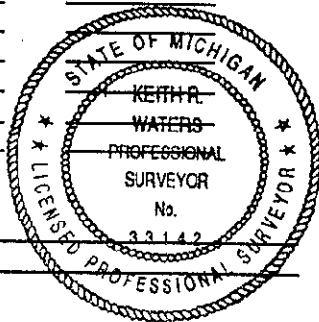

- 4. Lot No. _____, Recorded Plat _____
- 5. Private Claims _____

Keith R. Waters 11/11 96
I, _____, in a field survey on _____, 19____ do hereby state that under requirements of P.A. 74, Michigan P.A. of 1970, the corner points mentioned in lines 1 and 2 above were in conformance with regulations and rules therefore as required in the current manual of survey instructions of the United States Department of the Interior, Bureau of Land Management or by a decree of a Court of Law and /or that the corner points mentioned in lines 3, 4 and 5 above were in conformance with the rules of the Michigan Board of Land Surveyors or by a Decree of a Court of Law, established, re-established, monumented, recovered, found as expressed below:

NOTE: Not more than 2 corners, all in the same town and range, may be recorded on this certificate.

\$7.00 RECORDING FEE

\$2.00 HSSR

3/3/1997 5:01:18 PM Receipt #275
RECEIVED FOR RECORD
CHIPPEWA COUNTY - STATE OF MICHIGAN
SHARON H. KENNEDY, REGISTER OF DEEDS

BOOK 10 PAGE 4

Register of Deeds Stamp & File Number

	A	B	C	D	E	F	G	H	I	J	K	L	M
1													
2	6		5		4		3		2		1		
3													
4	7		8		9		10		11		12		
5													
6	18		17		16		15		14		13		
7													
8	19		20		21		22		23		24		
9													
10	30		29		28		27		26		25		
11													
12	31		32		33		34		35		36		
13													

A. Description of original monument and accessories and/or subsequent restoration:

D-11 1/4 Corner Common to Sections 29 & 32, Town 46 North, Range 1 West
1845 - Original ties (James Mullett): Fir 10, N25°W 15 links - Birch 12, S08°E 20 links.
1905 - County Surveyor Frederick H. Brown notes "an original corner, took distance west before corner was destroyed."
Distance to original section corner west is shown as 2578 feet. Distance to section corner east is shown as 2629 feet.

B. Description of corner evidence found and/or method applied in restoring or reestablishing corner:

This corner is being re-established as part of the Chippewa County Remonumentation Program.
Found no evidence of corner. The straight line distance between recovered original section corner location at C-11 and the re-established section corner at E-11 (E-11 was re-established independently of C-11) is 5207.36 feet, as compared to 5207 feet according to above mentioned 1905 Frederick H. Brown notes. Re-established corner at proportionate distance east-west with said Brown notes, north-south position determined by split of right-of-way fences approximately 66 feet apart. Corner is 2629.26 feet from section corner to the east, 2578.25 feet from section corner to the west, and is 20.2 feet south of a straight line between said section corners.

C. Description of monument for corner and accessories established to perpetuate locating the position of the corner:

Corner is a 3/4" x 24" rebar approximately 2 feet south of the centerline of east-west gravel road (11 Mile Road), approximately 6 feet west of a fence line to the south. Witnesses:
Power Pole, N89°E 384.14'
Power Pole, N81°W 316.13'
Power Pole, N09°E 32.74'
Fence Post, N53°E 50.59'

Note: Unless noted otherwise, distances are to a nail/tag #33142 in the side of the witness object. Bearings are compass bearings corrected for declination.



Signed by Keith R. Waters
Surveyor's Michigan License No. 33142

Date 12-30-96

BOOK 10 PAGE 4