

**SURVEY &
REMONUMENTATION**

APR 27 1995

CHIPPEWA COUNTY REMONUMENTATION CORNER

LAND CORNER RECORDATION CERTIFICATE

Filing Requirement of Act 74, Mich. P.A. 1970

For corners in **COMMISSION**

Chippewa (County)	Located In:	Corner Code #
1. Public Land Survey	T <u>46N</u> R <u>1W</u>	<u>D-13</u>
	T _____ R _____	_____
	T _____ R _____	_____
	T _____ R _____	_____
2. Property Controlling in Section	S _____ T _____ R _____	_____
	S _____ T _____ R _____	_____
3. Miscellaneous Property in Sec.	S _____ T _____ R _____	_____
	S _____ T _____ R _____	_____

\$ 7.00 LAND CORNER
\$ 2.00 MSSR
5 DEC 94 12:23 P.M. RECEIPT# 1518
RECEIVED FOR RECORD
CHIPPEWA COUNTY - STATE OF MICHIGAN
SHARON H. KENNEDY, REGISTER OF DEEDS
Register of Deeds Stamp & File Number

4. Lot No. _____, Recorded Plat _____
5. Private Claims _____

I, William L. Karr, in a field survey on October 28, 1994
do hereby certify that under requirements of P.A. 74, Michigan P.A. of 1970, the corner points mentioned
in lines 1 and 2 above were in conformance with regulations and rules therefore as required in the
current manual of survey instructions of the United States Department of the Interior, Bureau of Land
Management or by a decree of a Court of Law and/or that the corner points mentioned in lines 3, 4 and 5
above were in conformance with the rules of the Michigan Board of Land Surveyors or by a Decree of a
Court of Law; established, re-established, monumented, re-monumented, recovered, found as
expressed below:

**NOTE: Not more than 4 corners, all in the same town and range, may be recorded
on this certificate.**

A. Description of original monument and accessories and/or subsequent restoration:

(D-13) South 1/4 corner Section 32, T.46 N., R.1 W (Not common)

1840: Austin Burt set post. Spruce 16 N82E 09
Cedar 12 N89W 20

B. Description of corner evidence found and/or method applied in restoring or reestablishing corner:


(D-13) This corner is being re-established as part of the Chippewa County
Remonumentation program.

Found no evidence of original corner. Found remains of old fenceline to the
North. Re-established corner position on the extension of fenceline on the
Township line using Standard Corner 31/32 and Standard Corner 32/33. Corner
falls 21.45' West of the North 1/4 corner of Section 5 (GLO is 22.44').

C. Description of monument for corner and accessories established to perpetuate locating the position of the corner:

(D-13) Corner is a 3/4"x 24" iron with aluminum "Chippewa County Remonumentation"
cap approximately 5' South of the centerline of a two track.

Witnesses: 5" Balsam Fir	N40°W	27.99'
5" Balsam Fir	S65°W	29.17'
12" Spruce	S71°E	46.87'
10" Spruce	N70°E	54.62'
North 1/4 Corner Section 5	East	21.45'

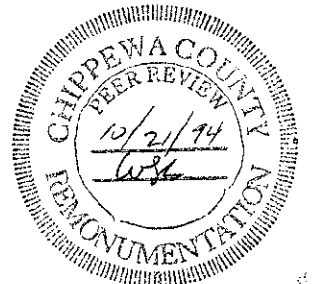

Signed by William L. Karr Date 12/2/94

Surveyor's Michigan License No. 27450

723-12

NOTE: Bearings are compass bearings corrected for declination.
Distances are to a nail in side of witness objects unless noted.