

SURVEY & REMONUMENTATION

MAY 28 1997 CHIPPEWA COUNTY REMONUMENTATION CORNER

COMMISSION

LAND CORNER RECORDATION CERTIFICATE
Filing Requirement of Act 74, Mich. P.A. 1970


For corners in

Chippewa Located In: Corner Code #
(County)

1. Public Land Survey T46N R 1W E-2
T R
T R
T R

2. Property Controlling S T R
in Section S T R

3. Miscellaneous S T R
Property in Sec. S T R

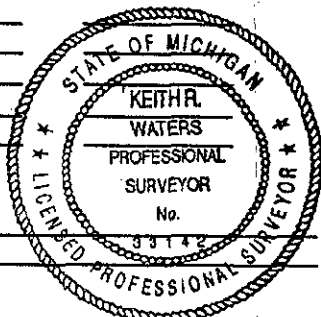

\$7.00 RECORDING FEE

\$2.00 MSSR

3/3/1997 5:01:39 PM Receipt #275
RECEIVED FOR RECORD
CHIPPEWA COUNTY - STATE OF MICHIGAN
SHARON H. KENNEDY, REGISTER OF DEEDS

BOOK 10 PAGE 5

Register of Deeds Stamp & File Number

4. Lot No. _____, Recorded Plat _____
5. Private Claims _____

I, Keith R. Waters, in a field survey on 08/23, 1996 do hereby state that under requirements of P.A. 74, Michigan P.A. of 1970, the corner points mentioned in lines 1 and 2 above were in conformance with regulations and rules therefore as required in the current manual of survey instructions of the United States Department of the Interior, Bureau of Land Management or by a decree of a Court of Law and/or that the corner points mentioned in lines 3, 4 and 5 above were in conformance with the rules of the Michigan Board of Land Surveyors or by a Decree of a Court of Law; established, re-established, monumented, recovered, found as expressed below:

NOTE: Not more than 2 corners, all in the same town and range, may be recorded on this certificate.

	A	B	C	D	E	F	G	H	I	J	K	L	M
1													
2	6			5	●	4		3		2			1
3													
4	7			8		9		10		11			12
5													
6	18			17		16		15		14			13
7													
8	19			20		21		22		23			24
9													
10	30			29		28		27		26			25
11													
12	31			32		33		34		35			36
13													

A. Description of original monument and accessories and/or subsequent restoration:


E-2 1/4 Corner Common to Sections 4 & 5, Town 46 North, Range 1 West
1845 - Original ties (James Mullett): Spruce 10, S62°W 04 links - Fir 10, S50°E 20 links.
1890 - County Surveyor Frederick H. Brown notes indicate "an original government corner, the bearing trees were standing and set post from same."
1982 - William L. Karr, P.S. 27450, LCRC in liber 7, page 2, Chippewa County corner records. Found no evidence of corner. Set corner from local evidence (fence lines, road location). Witnesses to set 1" drill rod: Power Pole, N88°W 50.85' - Wood Fence Post, S74°W 54.03' - Metal Fence Post, N86°E 51.30' - Michigan Bell Box, N37°E 78.91'.

B. Description of corner evidence found and/or method applied in restoring or reestablishing corner:

This corner is being perpetuated as part of the Chippewa County Remonumentation Program. Found a 1" drill rod approximately 3 feet east of the centerline of a north-south gravel road (Maple Road), on the extension of a fence line to the west. Also found two witness objects as called for in LCRC liber 7, page 2. The distances to the section corner to the south and the closing corner to the north are within 1 foot of the pro-rated distances as shown in above mentioned Frederick H. Brown notes. Accepted corner as found and established additional witness objects.

C. Description of monument for corner and accessories established to perpetuate locating the position of the corner:

Corner is a 1" drill rod approximately 3 feet east of the centerline of a north-south gravel road (Maple Road), on the extension of a fence line to the west. Witnesses:
Power Pole, N88°W 51.04'
Fence Post, S63°W 57.72' (nail and tag #33142 on top)
4" Spruce, N31°E 101.78'
Center of Top of Michigan Bell Box, N37°E 78.62'
Northwest Corner of Metal Barn, N74°E 112.38'
Note: Unless noted otherwise, distances are to a nail and tag in the side of the witness object. Bearings are compass bearings corrected for declination.

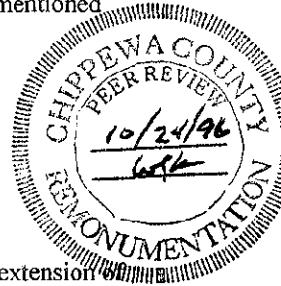

Signed by Keith R. Waters
Surveyor's Michigan License No. 33142

Date 12-30-96
BOOK 10 PAGE 5