

SURVEY & REMONUMENTATION

MAY 28 1997

COMMISSION CHIPPEWA COUNTY REMONUMENTATION CORNER

**LAND CORNER RECORDATION CERTIFICATE
Filing Requirement of Act 74, Mich. P.A. 1970**

For corners in

Chippewa (County)	Located In:	Corner Code #
1. Public Land Survey	T <u>46N</u> R <u>1W</u>	<u>E-3</u>
	T _____ R _____	_____
	T _____ R _____	_____
	T _____ R _____	_____
2. Property Controlling in Section	S _____ T _____	_____
	S _____ T _____	_____
3. Miscellaneous Property in Sec.	S _____ T _____	_____
	S _____ T _____	_____

\$7.00 RECORDING FEE

\$2.00 MSSR


3/3/1997 5:02:06 PM Receipt #275
RECEIVED FOR RECORD
CHIPPEWA COUNTY - STATE OF MICHIGAN
SHARON H. KENNEDY, REGISTER OF DEEDS

BOOK 10 PAGE 6
Stamp & File Number

4. Lot No. _____, Recorded Plat _____
5. Private Claims _____


I, Keith R. Waters, in a field survey on 08/23, 1996 do hereby state that under requirements of P.A. 74, Michigan P.A. of 1970, the corner points mentioned in lines 1 and 2 above were in conformance with regulations and rules therefore as required in the current manual of survey instructions of the United States Department of the Interior, Bureau of Land Management or by a decree of a Court of Law and /or that the corner points mentioned in lines 3, 4 and 5 above were in conformance with the rules of the Michigan Board of Land Surveyors or by a Decree of a Court of Law; established, re-established, monumented, recovered, found as expressed below:

NOTE: Not more than 2 corners, all in the same town and range, may be recorded on this certificate.

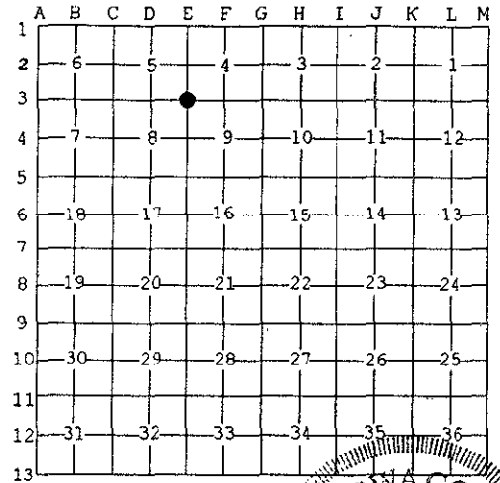

A. Description of original monument and accessories and/or subsequent restoration:

- E-3 Corner Common to Sections 4, 5, 8, & 9, Town 46 North, Range 1 West
- 1845 - Original tie (James Mullett): White Pine 24, N80°E 25 links - White Pine 24, S42°W 46 links.
- 1908 - County Surveyor Frederick H. Brown notes indicate an original corner, large cedar post.
- 1972 - Chippewa County Road Commission corner record, liber 3, page 207, Chippewa County corner records. Cedar Post with Drift Pin. Witnesses: Fence Post, SW 57.35' - Fence Post, NW 64.80' - Fence Post, NE 60.10'.
- 1982 - William L. Karr, P.S. 27450, LCRC in liber 7, page 2, Chippewa County corner records. Found no evidence of corner. Re-set from local evidence (fence lines, roads). Witnesses to set 1" drill rod: Corner fence post, N55°W 55.16' - Corner fence post, N62°E 52.06' - 6" Poplar, S62°E 98.13' - Power Pole, S28°W 118.08'.

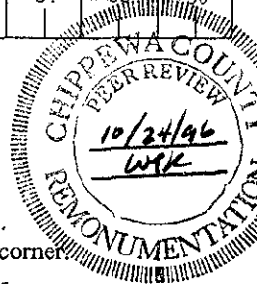

B. Description of corner evidence found and/or method applied in restoring or reestablishing corner:

This corner is being perpetuated as part of the Chippewa County Remonumentation Program. Found a 1" drill rod in the intersection of a north-south gravel road and a seasonal road to the west. Also found two of the witness objects as called for in LCRC liber 7, page 2. Distances to other corners in the area are consistent with above mentioned Frederick H. Brown notes. Accepted corner as found and established additional witness objects.



C. Description of monument for corner and accessories established to perpetuate locating the position of the corner:

Corner is a 1" drill rod approximately 5 feet east of the centerline of a north-south gravel road (Maple Road), at a seasonal road to the west. Witnesses:
10" Aspen, S62°E 97.82'
Power Pole, S32°W 118.05'
Power Pole, N12°W 239.00'
Fence Post, N83°E 44.44' (nail and tag #33142 in top)

Note: Unless noted otherwise, distances are to a nail and tag in the side of the witness object. Bearings are compass bearings corrected for declination. Trees are blazed and painted.

Signed by Keith R. Waters
Surveyor's Michigan License No. 33142

Date 12-30-96

BOOK 10 PAGE 6