

SURVEY & REMONUMENTATION

MAY 28 1997

CHIPPEWA COUNTY REMONUMENTATION CORNER

COMMISSION

LAND CORNER RECORDATION CERTIFICATE
Filing Requirement of Act 74, Mich. P.A. 1970

For corners in

Chippewa Located In: Corner Code #
(County)

- 1. Public Land Survey T46N R1W E-5
T R
T R
T R
- 2. Property Controlling in Section S T R
S T R
- 3. Miscellaneous Property in Sec. S T R
S T R



- 4. Lot No. Recorded Plat
- 5. Private Claims

\$7.00 RECORDING FEE

\$2.00 MSSR

3/3/1997 5:03:16 PM Receipt #275
RECEIVED FOR RECORD
CHIPPEWA COUNTY - STATE OF MICHIGAN
SHARON H. KENNEDY, REGISTER OF DEEDS

BOOK 10 PAGE 8

Register of Deeds Stamp & File Number

I, Keith R. Waters, in a field survey on 10/31, 1996 do hereby state that under requirements of P.A. 74, Michigan P.A. of 1970, the corner points mentioned in lines 1 and 2 above were in conformance with regulations and rules therefore as required in the current manual of survey instructions of the United States Department of the Interior, Bureau of Land Management or by a decree of a Court of Law and/or that the corner points mentioned in lines 3, 4 and 5 above were in conformance with the rules of the Michigan Board of Land Surveyors or by a Decree of a Court of Law; established, re-established, monumented, recovered, found as expressed below:

NOTE: Not more than 2 corners, all in the same town and range, may be recorded on this certificate.


	A	B	C	D	E	F	G	H	I	J	K	L	M
1													
2	6			5		4		3		2		1	
3													
4	7			8		9		10		11		12	
5													
6	18			17		16		15		14		13	
7													
8	19			20		21		22		23		24	
9													
10	30			29		28		27		26		25	
11													
12	31			32		33		34		35		36	
13													

A. Description of original monument and accessories and/or subsequent restoration:

E-5 Corner Common to Sections 8, 9, 16, & 17, Town 46 North, Range 1 West
1845 - Original ties (James Mullett): Spruce 10, S11°W 05 links - Black Ash 12, N69°E 22 links.
1890, 1908, 1910 - County Surveyor Frederick H. Brown notes indicate an original corner with original bearing tree standing.
Witness: 10" White Pine, N62½°W 58'.
1992 - Certificate of Survey, liber 605, page 692, Chippewa County records, shows a ½" rod at this corner position. Witnesses:
Sign Post, S28°E 48.95' - Power Pole, N52°E 50.7' - Fence Post, N70°W 76.3' - Stop Sign, S75°W 35.4'.

B. Description of corner evidence found and/or method applied in restoring or reestablishing corner:

This corner is being perpetuated as part of the Chippewa County Remonumentation Program.
Found a ½" rebar at the surface of gravel road intersection as called for in above mentioned Certificate of Survey. Also found a 5/8" iron bar 34 inches below gravel surface, S66°W 0.45 feet from ½" rebar. Accepted the 5/8" iron bar as best available evidence of corner location.
Placed a ¾" x 24" rebar with a plastic Chippewa County Remonumentation cap over the found 5/8" bar.

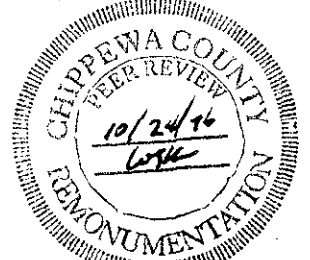

C. Description of monument for corner and accessories established to perpetuate locating the position of the corner:

Corner is a ¾" x 24" rebar with a plastic Chippewa County Remonumentation in the centerline of a north-south gravel road (Maple Road), at the intersection of seasonal roads east and west (8 Mile Road). Witnesses:
6" Aspen, S87°W 161.20'
Power Pole (DR4-40-15), N55°E 51.16' (nail and tag #22428 in side)
Power Pole (DR4-40-15M), S88°E 435.49'
Power Pole, S04°E 371.64'

Note: Unless noted otherwise, distances are to a nail/tag #33142 in the side of the witness object. Bearings are compass bearings corrected for declination. Trees are blazed and painted.

Signed by Keith R. Waters
Surveyor's Michigan License No. 33142

Date 12-30-96
BOOK 10 PAGE 8