

**SURVEY &  
REMONUMENTATION**

**MAY 28 1997 CHIPPEWA COUNTY REMONUMENTATION CORNER**


**COMMISSION**

**LAND CORNER RECORDATION CERTIFICATE  
Filing Requirement of Act 74, Mich. P.A. 1970**

For corners in

Chippewa \_\_\_\_\_ Located In: \_\_\_\_\_ Corner Code # \_\_\_\_\_  
(County)

- 1. Public Land Survey T46N R1W E-6  
T \_\_\_\_\_ R \_\_\_\_\_  
T \_\_\_\_\_ R \_\_\_\_\_  
T \_\_\_\_\_ R \_\_\_\_\_
- 2. Property Controlling S \_\_\_\_\_ T \_\_\_\_\_ R \_\_\_\_\_  
in Section S \_\_\_\_\_ T \_\_\_\_\_ R \_\_\_\_\_
- 3. Miscellaneous S \_\_\_\_\_ T \_\_\_\_\_ R \_\_\_\_\_  
Property in Sec. S \_\_\_\_\_ T \_\_\_\_\_ R \_\_\_\_\_

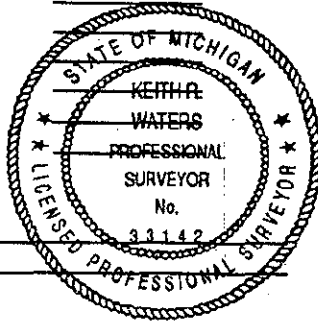

- 4. Lot No. \_\_\_\_\_, Recorded Plat \_\_\_\_\_
- 5. Private Claims \_\_\_\_\_

\$7.00 RECORDING FEE

\$2.00 MSSR

3/3/1997 5:03:55 PM Receipt #275  
RECEIVED FOR RECORD  
CHIPPEWA COUNTY - STATE OF MICHIGAN  
SHARON H. KENNEDY, REGISTER OF DEEDS  
BOOK 10 PAGE 9

Register of Deeds Stamp & File Number

I, Keith R. Waters, in a field survey on 10/31, 1996 do hereby state that under requirements of P.A. 74, Michigan P.A. of 1970, the corner points mentioned in lines 1 and 2 above were in conformance with regulations and rules therefore as required in the current manual of survey instructions of the United States Department of the Interior, Bureau of Land Management or by a decree of a Court of Law and/or that the corner points mentioned in lines 3, 4 and 5 above were in conformance with the rules of the Michigan Board of Land Surveyors or by a Decree of a Court of Law; established, re-established, monumented, recovered, found as expressed below:

NOTE: Not more than 2 corners, all in the same town and range, may be recorded on this certificate.


|    |    |   |    |   |    |   |    |   |    |   |    |   |
|----|----|---|----|---|----|---|----|---|----|---|----|---|
| A  | B  | C | D  | E | F  | G | H  | I | J  | K | L  | M |
| 1  |    |   |    |   |    |   |    |   |    |   |    |   |
| 2  | 6  |   | 5  |   | 4  |   | 3  |   | 2  |   | 1  |   |
| 3  |    |   |    |   |    |   |    |   |    |   |    |   |
| 4  | 7  |   | 8  |   | 9  |   | 10 |   | 11 |   | 12 |   |
| 5  |    |   |    |   |    |   |    |   |    |   |    |   |
| 6  | 18 |   | 17 | ● | 16 |   | 15 |   | 14 |   | 13 |   |
| 7  |    |   |    |   |    |   |    |   |    |   |    |   |
| 8  | 19 |   | 20 |   | 21 |   | 22 |   | 23 |   | 24 |   |
| 9  |    |   |    |   |    |   |    |   |    |   |    |   |
| 10 | 30 |   | 29 |   | 28 |   | 27 |   | 26 |   | 25 |   |
| 11 |    |   |    |   |    |   |    |   |    |   |    |   |
| 12 | 31 |   | 32 |   | 33 |   | 34 |   | 35 |   | 36 |   |
| 13 |    |   |    |   |    |   |    |   |    |   |    |   |

**A. Description of original monument and accessories and/or subsequent restoration:**

E-6 1/4 Corner Common to Sections 16 & 17, Town 46 North, Range 1 West  
1845 - Original corner (James Mullett) was a 10" Fir.  
1890 - County Surveyor Frederick H. Brown notes indicate "could not find any trace of 1/4 post as it was cut over and burned clean when I first looked for it and divide up what I found on the line, it being long." His sketch shows a distance of 5675 feet for the mile. Another penciled in note shows a distance of 5664 feet in 1912.

**B. Description of corner evidence found and/or method applied in restoring or reestablishing corner:**

This corner is being re-established as part of the Chippewa County Remonumentation Program.  
Found no evidence of corner. Re-established corner by single proportionate measurement on line between section corners north and south. The distance between said section corners is 5662.36 feet (above mentioned Brown notes show 5664 feet in 1912). Corner falls in the centerline of north-south gravel road (Maple Road).

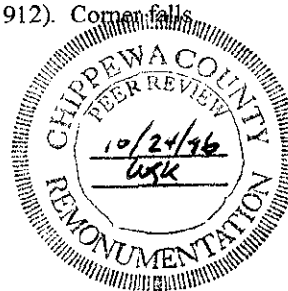

**C. Description of monument for corner and accessories established to perpetuate locating the position of the corner:**

Corner is a 3/4" x 24" rebar with a plastic Chippewa County Remonumentation cap in the centerline of a north-south gravel road. (Maple Road). Witnesses:  
Power Pole, S06°E 327.11'  
Power Pole, N30°E 79.80'  
Power Pole, N08°E 470.88'  
1/2" Iron w/cap #33142 on east-west 1/4 Section 16, S86°E 50.00'

Note: Unless noted otherwise, distances are to a nail/tag #33142 in the side of the witness object. Bearings are compass bearings corrected for declination.

Signed by Keith R. Waters  
Surveyor's Michigan License No. 33142

Date 12-30-96  
BOOK 10 PAGE 9