

**SURVEY &
REMONUMENTATION** CHIPPEWA COUNTY REMONUMENTATION CORNER

APR 27 1995

LAND CORNER RECORDATION CERTIFICATE
Filing Requirement of Act 74, Mich. P.A. 1970


For corners in
Chippewa **COMMISSION**
(County)

Located In:	Corner Code #:
T <u>46N</u> R <u>1W</u>	<u>E-7</u>
T _____ R _____	_____
T _____ R _____	_____
T _____ R _____	_____
T _____ R _____	_____
2. Property Controlling in Section S _____ T _____ R _____	_____
S _____ T _____ R _____	_____
3. Miscellaneous Property in Sec. S _____ T _____ R _____	_____
S _____ T _____ R _____	_____

\$ 7.00 LAND CORNER
\$ 2.00 HSSR
19 DEC 94 10:16 A.M. RECEIPT# 1769
RECEIVED FOR RECORD
CHIPPEWA COUNTY - STATE OF MICHIGAN
SHARON H. KENNEDY, REGISTER OF DEEDS
Register of Deeds Stamp & File Number

4. Lot No. _____, Recorded Plat _____
5. Private Claims _____

I, William L. Karr, in a field survey on October 19, 1994, do hereby certify that under requirements of P.A. 74, Michigan P.A. of 1970, the corner points mentioned in lines 1 and 2 above were in conformance with regulations and rules therefore as required in the current manual of survey instructions of the United States Department of the Interior, Bureau of Land Management or by a decree of a Court of Law and/or that the corner points mentioned in lines 3, 4 and 5 above were in conformance with the rules of the Michigan Board of Land Surveyors or by a Decree of a Court of Law; established, re-established, monumented, re-monumented, recovered, found as expressed below:

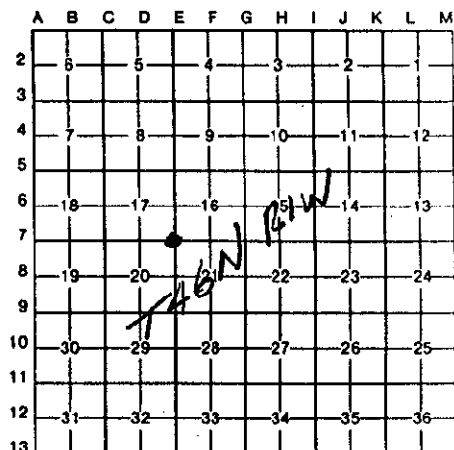

NOTE: Not more than 4 corners, all in the same town and range, may be recorded on this certificate.

A. Description of original monument and accessories and/or subsequent restoration:
(E-7) Section Corner 16, 17, 20 & 21, T.46 N., R.1 W.

1845: J. Mullett set post cor to Sections 16, 17, 20 & 21 Birch 10 N61E 06 lks Maple 12 S56W 48 lks

1984: W.L. Karr found a monument box in M-28 with no iron or cover. Set 3/4" iron in center of monument box. Corner was recorded in L.06 of corners, P.141

1988: N.E. Hill(MDOT) found 3/4" iron in monument box with recorded witnesses and accepted as found. Re-recorded in L.07 of corners, P.077.

B. Description of corner evidence found and/or method applied in restoring or reestablishing corner:


(E-7) This corner is being perpetuated as part of the Chippewa County Remonumentation program.

Found no evidence of original corner position. Found 3/4" iron in monument box as previously recorded with all witnesses. Added (2) witnesses and accepted corner position as found.

C. Description of monument for corner and accessories established to perpetuate locating the position of the corner:

(E-7) Corner is a 3/4" iron with plastic "Chippewa County Remonumentation" cap, 2.8' North of the centerline of M-28 and on the extension of the centerline of Maple Road to the South and 3.4' East of the centerline of Maple Road to the North.

Witnesses: P. Pole(DR4/40/1)	N18°E	120.86'
P. Pole(DR4/39)	S18°E	64.53'
P. Pole(DR4/39/1)	S08°E	126.02'
NE corner H.wall	S18°W	47.90'
P. Pole(DR4/40)	S80°W	216.29'
P. Pole(cut off)	N45°W	83.23'

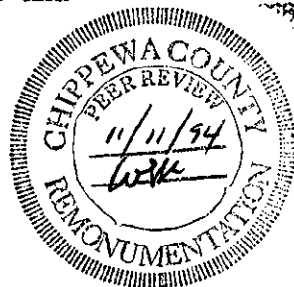

Signed by William L. Karr Date 12/7/94

Surveyor's Michigan License No. 27450

723-12

NOTE: Bearings are compass bearings corrected for declination. Distances are to a nail, in side of witness objects unless noted.