

SURVEY & REMONUMENTATION

MAY 28 1997

CHIPPEWA COUNTY REMONUMENTATION CORNER

COMMISSION

LAND CORNER RECORDATION CERTIFICATE

Filing Requirement of Act 74, Mich. P.A. 1970

For corners in

Chippewa

(County)

Located In:

Corner Code #

1. Public Land Survey

T46N R 1W

E-10

T R

T R

T R

2. Property Controlling in Section

S T R

S T R


3. Miscellaneous Property in Sec.

S T R

S T R

4. Lot No. , Recorded Plat

5. Private Claims

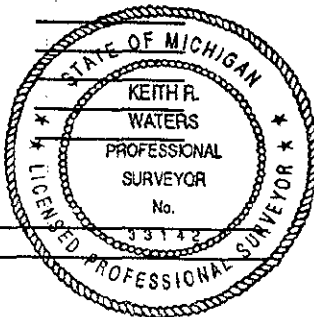

\$7.00 RECORDING FEE

\$2.00 MSSR

3/3/1997 5:05:13 PM Receipt #275
RECEIVED FOR RECORD
CHIPPEWA COUNTY - STATE OF MICHIGAN
SHARON H. KENNEDY, REGISTER OF DEEDS

BOOK 10 PAGE 12

Register of Deeds Stamp & File Number

	A	B	C	D	E	F	G	H	I	J	K	L	M
1													
2		6		5		4		3		2		1	
3													
4		7		8		9		10		11		12	
5													
6		18		17		16		15		14		13	
7													
8		19		20		21		22		23		24	
9													
10		30		29		28		27		26		25	
11													
12		31		32		33		34		35		36	
13													

I, Keith R. Waters, in a field survey on 11/11, 1996 do hereby state that under requirements of P.A. 74, Michigan P.A. of 1970, the corner points mentioned in lines 1 and 2 above were in conformance with regulations and rules therefore as required in the current manual of survey instructions of the United States Department of the Interior, Bureau of Land Management or by a decree of a Court of Law and/or that the corner points mentioned in lines 3, 4 and 5 above were in conformance with the rules of the Michigan Board of Land Surveyors or by a Decree of a Court of Law; established, re-established, monumented, recovered, found as expressed below:

NOTE: Not more than 2 corners, all in the same town and range, may be recorded on this certificate.

A. Description of original monument and accessories and/or subsequent restoration:

E-10 1/4 Corner Common to Sections 28 & 29, Town 46 North, Range 1 West


1845 - Original corner (James Mullett) was a 10" Fir.

1903, 1907 - County Surveyor Frederick H. Brown notes for Sections 28 and 29 show corner midway between section corners 2606 feet north and south. He indicates no evidence of the original corner at that time.

B. Description of corner evidence found and/or method applied in restoring or reestablishing corner:

This corner is being re-established as part of the Chippewa County Remonumentation Program.

Found no evidence of corner. Re-established corner by single proportionate measurement according to the original GLO notes between section corners 2602.95 feet north and 2602.95 feet south. Corner falls in the approximate centerline of north-south asphalt road.

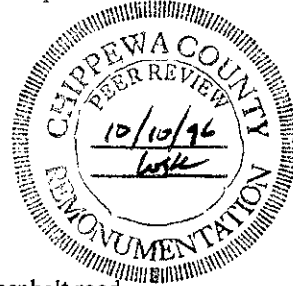

C. Description of monument for corner and accessories established to perpetuate locating the position of the corner:

Corner is a 3/4" x 24" rebar with a plastic Chippewa County Remonumentation cap in the centerline of north-south asphalt road.

Witnesses:

5" Spruce, S16°W 102.95'

Power Pole (DR4-39-24), S34°W 73.44'

Power Pole (DR4-39-24M), S73°E 142.00'

Power Pole, (DR4-39-25), S43°W 73.64'

Note: Unless noted otherwise, distances are to a nail/tag #33142 in the side of the witness object. Bearings are compass bearings corrected for declination. Trees are blazed and painted.

Signed by Keith R. Waters

Date 12-30-96

Surveyor's Michigan License No. 33142

BOOK 10 PAGE 12