

MAY 28 1997

COMMISSION

CHIPPEWA COUNTY REMONUMENTATION CORNER

LAND CORNER RECORDATION CERTIFICATE
Filing Requirement of Act 74, Mich. P.A. 1970

For corners in

Chippewa

(County)

Located In:

Corner Code #

1. Public Land Survey

T46N R 1W

E-11

T ___ R ___

T ___ R ___

T ___ R ___

2. Property Controlling in Section

S ___ T ___ R ___

S ___ T ___ R ___


3. Miscellaneous Property in Sec.

S ___ T ___ R ___

S ___ T ___ R ___

4. Lot No. _____, Recorded Plat _____

5. Private Claims _____

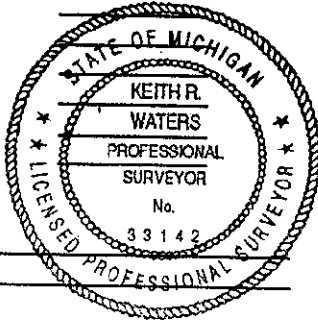

\$7.00 RECORDING FEE

\$2.00 NCSR

3/3/1997 5:05:35 PM Receipt #275
 RECEIVED FOR RECORD
 CHIPPEWA COUNTY - STATE OF MICHIGAN
 SHARON H. KENNEDY, REGISTER OF DEEDS

BOOK 10 PAGE 13

Register of Deeds Stamp & File Number

I, Keith R. Waters, in a field survey on 05/01, 1996 do hereby state that under requirements of P.A. 74, Michigan P.A. of 1970, the corner points mentioned in lines 1 and 2 above were in conformance with regulations and rules therefore as required in the current manual of survey instructions of the United States Department of the Interior, Bureau of Land Management or by a decree of a Court of Law and /or that the corner points mentioned in lines 3, 4 and 5 above were in conformance with the rules of the Michigan Board of Land Surveyors or by a Decree of a Court of Law; established, re-established, monumented, recovered, found as expressed below:

NOTE: Not more than 2 corners, all in the same town and range, may be recorded on this certificate.

	A	B	C	D	E	F	G	H	I	J	K	L	M
1													
2	6		5		4		3		2		1		
3													
4	7		8		9		10		11		12		
5													
6	16		17		18		19		20		21		22
7													
8	19		20		21		22		23		24		
9													
10	30		29		28		27		26		25		
11													
12	31		32		33		34		35		36		
13													

A. Description of original monument and accessories and/or subsequent restoration:

E-11 Corner Common to Sections 28, 29, 32, & 33, Town 46 North, Range 1 West
 1845 - Original ties (James Mullett): Fir 10, S52½°E 30 links - Fir 10, N37°W 22 links.
 1891 - County Surveyor Frederick H. Brown notes "could not find any corner and made one."
 Circa 1920's - County Surveyor notes indicate cement post with assorted witnesses.
 1977 - James H. Granger, P.S. 16041, LCRC in liber 1, page 274. Set ½" x 24" rebar and cap at proportionate distance from found south ¼ corner (Section 28) using section breakdown in County Surveyors office.
 Witnesses: Power Pole, N35°W 76.45' - Telephone Pole, N32°E 56.57' - Telephone Pole, S42°E 37.31' - 10" Spruce, S35°W 32.76'.


B. Description of corner evidence found and/or method applied in restoring or reestablishing corner:

This corner is being perpetuated as part of the Chippewa County Remonumentation Program.
 Found a ½" rebar with plastic cap #24599 as called for in LCRC liber 1, page 274. It appears that the corner was probably established by extending the line and doubling the distance from Section corner G-11 through ¼ corner F-11. Position works well with distances to Section corners C-11 to the west and E-9 to the north, as shown in above mentioned Frederick H. Brown notes. Accepted corner as found and established new witness objects.

C. Description of monument for corner and accessories established to perpetuate locating the position of the corner:

Corner is a ½" rebar with plastic cap #24599 approximately 5.5 feet east of the centerline of asphalt road to the north, on the centerline of east-west gravel road. Witnesses:
 Power Pole (DR4-39-33), N32°W 76.42'
 Power Pole, S69°E 132.05'
 Power Pole, S52°W 57.04'
 12" Spruce, N39°E 59.00' (small side blaze only)

Note: Unless noted otherwise, distances are to a nail/tag #33142 in the side of the witness object. Bearings are compass bearings corrected for declination.

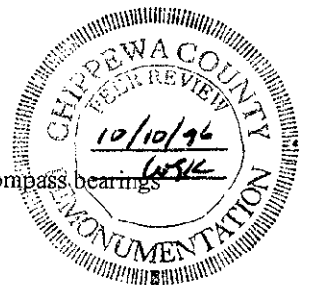

Signed by Keith R. Waters
 Surveyor's Michigan License No. 33142

Date 12-30-96
 BOOK 10 PAGE 13