

MAY 28 1997

COMMISSION

CHIPPEWA COUNTY REMONUMENTATION CORNER

LAND CORNER RECORDATION CERTIFICATE
Filing Requirement of Act 74, Mich. P.A. 1970

For corners in

Chippewa	Located In:	Corner Code #
(County)		
1. Public Land Survey	T46N R 1W	E-12
	T R	
	T R	
	T R	
2. Property Controlling in Section	S T R	
	S T R	
3. Miscellaneous Property in Sec.	S T R	
	S T R	

\$7.00 RECORDING FEE

\$2.00 MSSR

3/3/1997 5:05:56 PM Receipt #275
RECEIVED FOR RECORD
CHIPPEWA COUNTY - STATE OF MICHIGAN
SHARON H. KENNEDY, REGISTER OF DEEDS

BOOK 10 PAGE 14

Register of Deeds Stamp & File Number

4. Lot No. _____, Recorded Plat _____
5. Private Claims _____

I, Keith R. Waters, in a field survey on 05/01, 1996 do hereby state that under requirements of P.A. 74, Michigan P.A. of 1970, the corner points mentioned in lines 1 and 2 above were in conformance with regulations and rules therefore as required in the current manual of survey instructions of the United States Department of the Interior, Bureau of Land Management or by a decree of a Court of Law and /or that the corner points mentioned in lines 3, 4 and 5 above were in conformance with the rules of the Michigan Board of Land Surveyors or by a Decree of a Court of Law; established, re-established, monumented, recovered, found as expressed below:

NOTE: Not more than 2 corners, all in the same town and range, may be recorded on this certificate.

1	A	B	C	D	E	F	G	H	I	J	K	L	M
2		6		5		4		3		2		1	
3													
4		7		8		9		10		11		12	
5													
6		18		17		16		15		14		13	
7													
8		19		20		21		22		23		24	
9													
10		30		29		28		27		26		25	
11													
12		31		32		33		34		35		36	
13													

A. Description of original monument and accessories and/or subsequent restoration:

E-12 1/4 Corner Common to Sections 32 & 33, Town 46 North, Range 1 West

1845 - Original corner (James Mullett) was a 10" Spruce.

1980 - William L. Karr, P.S. 27450, LCRC in liber 5, page 42, Chippewa County corner records. Found a 1" iron pin in poor condition. Replaced with a 1/2" rerod.


Witnesses: 3" Spruce, S22°E 78.08' - 10" Poplar, S36°W 46.20' - Fence Post, S85°W 22.78'.



B. Description of corner evidence found and/or method applied in restoring or reestablishing corner:

This corner is being perpetuated as part of the Chippewa County Remonumentation Program.

Found a 1/2" rebar in the centerline of a north-south 2 track road, on the extension of a fence line to the west. Also found the fence post witness as described in LCRC liber 5, page 42. All other record witnesses are gone. Rebar is within 1.5 feet of a straight line between section corners north and south, and is also within 1.5 feet off being midway between said section corners. Accepted as found, replaced 1/2" rebar with a 3/4" x 24" rebar and plastic Chippewa County Remonumentation cap.

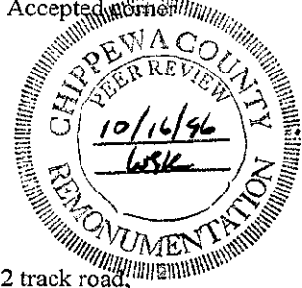

C. Description of monument for corner and accessories established to perpetuate locating the position of the corner:

Corner is a 3/4" x 24" rebar with a plastic Chippewa County Remonumentation cap in the centerline of a north-south 2 track road, on the extension of an old fence line to the west. Witnesses:

Fence Post, N88°W 23.02' (nail and tag #24599)

7" Balsam Fir, S81°W 84.57'

12" Spruce, S61°W 147.24'

7" Spruce, S12°W 115.12'

Center of Top of 5' High, 4" Diameter Steel Post, S20°E 91.66' (Post is 6' west of north-south landfill fence).

Note: Unless noted otherwise, distances are to a nail/tag #33142 in the side of the witness object. Bearings are compass bearings corrected for declination. Trees are blazed and painted.

Signed by Keith R. Waters
Surveyor's Michigan License No. 33142

Date 12-30-96
BOOK 10 PAGE 14