

SURVEY & REMONUMENTATION

CHIPPEWA COUNTY REMONUMENTATION CORNER

APR 27 1995


LAND CORNER RECORDATION CERTIFICATE
Filing Requirement of Act 74, Mich. P.A. 1970

For corners in **COMMISSION**

<u>Chippewa</u> <small>(County)</small>	Located In:	Corner Code #	
1. Public Land Survey	T <u>46N</u> R <u>1W</u>	<u>E-13</u>	
	T _____ R _____	_____	
	T _____ R _____	_____	
	T _____ R _____	_____	
2. Property Controlling in Section	S _____ T _____ R _____	_____	
	S _____ T _____ R _____	_____	
3. Miscellaneous Property in Sec.	S _____ T _____ R _____	_____	
	S _____ T _____ R _____	_____	

\$ 7.00 LAND CORNER
\$ 2.00 MSSR
5 DEC 94 12:24 P.M. RECEIPT# 1518
RECEIVED FOR RECORD
CHIPPEWA COUNTY - STATE OF MICHIGAN
SHARON H. KENNEDY, REGISTER OF DEEDS
Register of Deeds Stamp & File Number

4. Lot No. _____, Recorded Plat _____
5. Private Claims _____

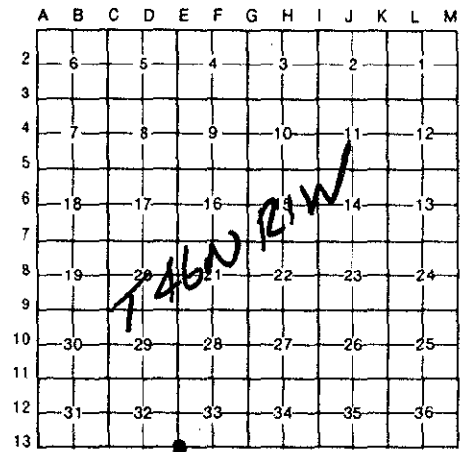


I, William L. Karr, in a field survey on October 28, 1994, do hereby certify that under requirements of P.A. 74, Michigan P.A. of 1970, the corner points mentioned in lines 1 and 2 above were in conformance with regulations and rules therefore as required in the current manual of survey instructions of the United States Department of the Interior, Bureau of Land Management or by a decree of a Court of Law and/or that the corner points mentioned in lines 3, 4 and 5 above were in conformance with the rules of the Michigan Board of Land Surveyors or by a Decree of a Court of Law; established, re-established, monumented, re-monumented, recovered, found as expressed below:

NOTE: Not more than 4 corners, all in the same town and range, may be recorded on this certificate.

A. Description of original monument and accessories and/or subsequent restoration:

- (E-13) Standard Corner Sections 32/33, T.46 N., R.1 W.
- 1840: Austin Burt set post Fir 6 N83E 15 Cedar N52W 11
 - 1946: R.H. Larsen used this as a common corner.
 - 1953: Bancroft Bufe used this corner as S.C. 32/33(L.2,P.1). I do not know if he found or set the monument, but the distance East to another monument is 5280.79' (his measurement is 5280.5').
 - 1977: J.H. Granger recorded this monument as C.C. 5/4 (L.1,P.250).

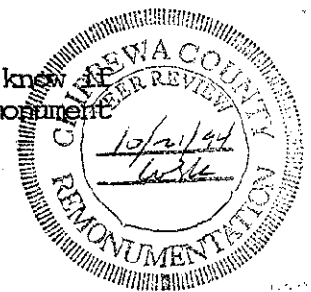

B. Description of corner evidence found and/or method applied in restoring or reestablishing corner:

(E-13) This corner is being perpetuated as part of the Chippewa County Remonumentation program.
Found no evidence of original corner. Found a 1/2" iron in old concrete 2' North of the centerline of 12 Mile Road and on the centerline extended of an old dirt road to the North. The monument falls 303' West of the centerline of the R.R. tracks. The South 1/4 corner of Section 32 is 2625.75' (County Surveyor notes from the early 1900's show 2628'). Closing corner 5/4 falls 19.80' to the East (19.80'-GLO). Accepted corner position as found for Standard Corner Sections 32/33.

C. Description of monument for corner and accessories established to perpetuate locating the position of the corner:

(E-13) Corner is a 1/2" iron in old concrete, 2' North of the centerline of 12 Mile road and on approximate centerline of old dirt road to the North.

Witnesses: P.Pole	N25°E	94.26'
S.W. Corner fence post	N51°E	48.47'
P.Pole (DR4/39E5/7)	S73°E	178.62'
P.Pole	S39°E	56.27'
Closing corner 5/4	East	19.80'



Signed by William L. Karr Date 12/2/94

Surveyor's Michigan License No. 27450

723-12

**NOTE: Bearings are compass bearings corrected for declination.
Distances are to a nail in side of witness objects unless noted.**