

SURVEY & REMONUMENTATION

MAR 09 1994

Chippewa County Remonumentation Corner

LAND CORNER RECORDATION CERTIFICATE
Filing Requirement of Act 74, Mich. P.A. 1970

RECEIVED FOR RECORD
CHIPPEWA COUNTY
STATE OF MICHIGAN

93 DEC 29 AM 10:24

For corners in **CHIPPENAW**

Chippewa

(County)

Located In:


Corner Code #

- | | | |
|---------------------------------------|--------------------------|------------|
| 1. Public Land Survey | T <u>46N</u> R <u>1W</u> | <u>F-1</u> |
| | T _____ R _____ | _____ |
| | T _____ R _____ | _____ |
| | T _____ R _____ | _____ |
| 2. Property Controlling in Section | S _____ T _____ R _____ | _____ |
| | S _____ T _____ R _____ | _____ |
| 3. Miscellaneous Property in Sec. | S _____ T _____ R _____ | _____ |
| | S _____ T _____ R _____ | _____ |
| 4. Lot No. _____, Recorded Plat _____ | | |
| 5. Private Claims _____ | | |

J. Roger McBeth
REGISTER OF DEEDS

Register of Deeds Stamp & File Number

I, William L. Karr, in a field survey on May 24, 19 93, do hereby certify that under requirements of P.A. 74, Michigan P.A. of 1970, the corner points mentioned in lines 1 and 2 above were in conformance with regulations and rules therefore as required in the current manual of survey instructions of the United States Department of the Interior, Bureau of Land Management or by a decree of a Court of Law and/or that the corner points mentioned in lines 3, 4 and 5 above were in conformance with the rules of the Michigan Board of Land Surveyors or by a Decree of a Court of Law; established, re-established, monumented, re-monumented, recovered, found as expressed below:

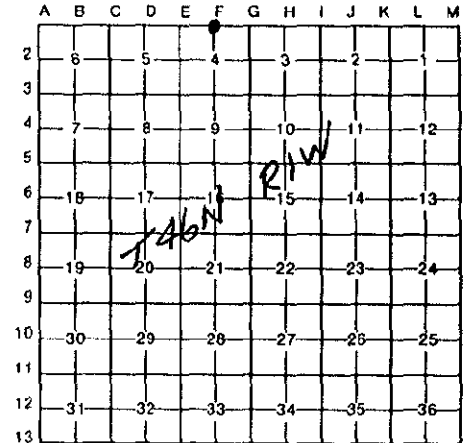

NOTE: Not more than 4 corners, all in the same town and range, may be recorded on this certificate.


A. Description of original monument and accessories and/or subsequent restoration:
(F-1) North 1/2 Corner of Section 4 (T46N-R1W)

Corner not set in original survey.

B. Description of corner evidence found and/or method applied in restoring or reestablishing corner:

(F-1) This corner is being perpetuated as part of the Chippewa County Remonumentation Program.

Found 1/2" iron L.S. 27450 in a monument box, 1.5' South of the present centerline of Six Mile Road. Corner has been used in many surveys. Originally re-established on previous centerline of Six Mile Road on an extension of a fence to the South in previous survey. Accepted corner position as found.

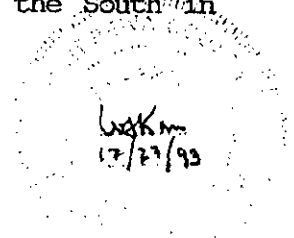

Description of monument for corner and accessories established to perpetuate locating the position of the corner:
(F-1) Corner is a 1/2" iron, L.S. 27450 in a monument box 1.5' South of the centerline of Six Mile Road. Falls on an extension of a fence to the South.

Witnesses:

- | | | |
|---|-------|---------|
| Power Pole (E-55) | S74°E | 154.87' |
| Phone Splice Box | South | 49.03' |
| Power Pole (E 58) | S29°W | 60.91' |
| Cut-off Power Pole | N45°W | 68.49' |
| South 1/2 Corner of Section 33 (1/2" Iron L.S. 27450) | East | 14.85' |



Witnessed by William L. Karr Date 12/23/93

Surveyor's Michigan License No. 27450

NOTE: Bearings are compass bearings corrected for declination. Distances are to a nail in side of witness objects unless noted.